

Blind copy to:

405  
114  
09A2A.42  
09A2 Chron

09A2A.42:SLC:mc  
Ser 09A2/608

16 MAY 1983

California Regional Water Quality Control Board  
San Francisco Bay Region  
1111 Jackson Steet, Room 6040  
Oakland, California 94607

Attention: Mr. Robert Samaniego

Subject: MCON Project P-183, Solid Waste Disposal System, Naval Air  
Station, Alameda, California; closure plan

Gentlemen:

Harding Lawson Associates (HLA), the Navy's designer of the subject project, has worked with your geologist, Mr. Bud Eagle, in hopes of resolving comments presented in your letter dated September 8, 1982. The enclosed ~~letter dated April 26, 1983~~ provides you with the response to Mr. Eagle's concerns. The Navy believes HLA has properly designed the subject project and with your approval, plans to construct the subject project in the Fall of 1983.

The enclosed Initial Assessment Study and HLA letter dated April 13, 1983, are provided for your information. The Initial Assessment Study suggests that additional testing be performed at the project site. The HLA letter provides the results of additional testing. This Command believes that the data in the letter further supports the HLA design as an appropriate landfill closure plan.

The Navy design team would like to meet with you as soon as possible to discuss the status of the closure plan approval. Please contact Mr. Jim Washington, (415) 877-7402, to schedule this meeting.

Sincerely,

W. L. ... III  
...  
...  
... Navy  
Asst. Head, Acquisition Dept.

Enclosures

- (1) HLA ltr 2176, 059.01 dtd April 26, 1983
- (2) Initial Assessment Study of Naval Air Station,  
Alameda dtd April 1983
- (3) HLA ltr 2176, 059.01 dtd April 13, 1983

Copy to:  
NAS Alameda  
NAVFACENGCOM Code 112



~~April 26, 1982~~

2176,059.01

Commanding Officer  
Western Division  
Naval Facilities Engineering Command  
P. O. Box 727  
San Bruno, California 94066

Attention: Mr. James Washington  
Code 405

Gentlemen:

This letter presents our response to a memorandum dated August 26, 1982, from the State Water Resources Control Board (SWRCB). The subject of the memorandum was a review of two documents concerning the sanitary landfill at the Alameda Naval Air Station, Alameda, California. It was written by Mr. Bud Eagle, Senior Engineering Geologist for Mr. Robert Samaniego of the California Regional Water Quality Control Board (CRWQCB). This review was undertaken in August 1982 although HLA had prepared and submitted the sanitary landfill site study in March 1978 and the closure plan on November 12, 1980.

HLA also has completed a basis of design report dated November 20, 1980, and construction plans and specifications entitled Solid Waste Disposal System dated February 5, 1982. The plans and specifications are for closing the landfill site in accordance with the CRWQCB's Resolution No. 77-7 (Minimum Criteria for Proper Closure of Class II Solid Waste Disposal Sites) and incorporating a dredged disposal facility into the closure design by installing dikes and a decant weir. We understand that Mr. Eagle has reviewed these more recent documents but still has some concerns about the project.

RECEIVED

APR 27 1982

INT. MAIL ROOM

April 26, 1983  
2176,059.01  
Commanding Officer, Western Division  
Naval Facilities Engineering Command  
Page 2

Harding Lawson Associates

The following are our specific comments to issues raised by Mr. Eagle:

- Concern was expressed that waste materials extend to depths of about 20 feet which is below the water table and is in violation of State code. It should be pointed out that this was standard construction practice prior to the promulgation of any state regulations. This practice was stopped in the early to mid-1970's and the wastes were placed above the water table until the site ceased operating. Therefore, this is an existing condition that occurred many years ago with no intention to violate the regulations. While strict interpretation of the regulations would consider this a violation, this is a condition shared by numerous landfills on the fringes of San Francisco Bay and it is not practical to attempt to remove the debris.
  
- Mr. Eagle stated that the wrong coefficient of permeability was used to calculate the seepage which produced an inaccurate estimate of discharge. However, a check of the March 1978 landfill site study report, page 73, shows that the correct coefficient of permeability of 0.01 centimeters per second (cps) and a seepage discharge of 7,000 to 13,000 gallons per day are correct. We do not know how Mr. Eagle arrived at the other figures. He further states that the use of an assumed coefficient of permeability is questionable and that the value "can vary by several orders of magnitude". This appears to be somewhat of an exaggeration as most textbooks define permeability for free-draining fine sand as varying from 0.1 to 0.001 cps. Therefore, the use of 0.01 cps appears to be a reasonable value.

In addition, HLA drilled 18 test borings in the hydraulic sand fill in a large area around Area 97 (east of the sea-plane lagoon) in 1979. Twenty tests were run to determine the amount of soil passing the No. 200 sieve. The results indicated that the average was 20 percent (4 to 40 percent) passing No. 200 sieve. Permeability tests run on two of the samples indicated permeabilities of  $4 \times 10^{-3}$  and  $4 \times 10^{-4}$  cps. Based on these data, using a permeability of  $1 \times 10^{-2}$  cps is very conservative.

April 26, 1983

2176,059.01

Commanding Officer, Western Division

Naval Facilities Engineering Command

Page 3

The rate of discharge for seepage that has flowed under the hydraulic fill in the dredged spoil area is discussed. It is Mr. Eagle's opinion that a higher flow rate should have been used. However, he apparently has not considered that the flow path under the dredged spoil area is many times further than the flow path where the debris is near the sea wall. Also, dilution is occurring as evidenced by recent water quality tests (attached) which show that the levels of various constituents which are in the water are lowest in this area.

- The recent water quality tests show that the levels of contaminants in the ground water are very low. It is still our opinion that with values as low as these that a cutoff wall is of questionable value. If the barrier was not installed and the water quality should decrease, there is a 60-foot width available between the sea wall and the toe of the dike to install the barrier at a later date.
- Mr. Eagle's concern that if only the western and southern perimeter areas were sealed with a barrier, uplift pressures might damage the impermeable cover if the "water table were to rise significantly". It is our opinion that if the western and southern perimeters were completely sealed,\* that the water level would only rise slightly before the overall ground-water flow would take the path of least resistance and flow around the landfill and drain into the bay north and east of the existing landfill where it is assumed that the perimeter dikes are also somewhat pervious. It is not known what is meant by a "significant rise in the water table". Since the hydraulic gradient is nearly flat, being about 0.001 foot/foot, a rise high enough to cause the cover to be damaged seems extremely unlikely.

---

\*HLA's recommendation was to only seal the portions of the south and west perimeters where the debris is adjacent to the sea wall, not all of these areas.

April 26, 1983  
2176,059.01  
Commanding Officer, Western Division  
Naval Facilities Engineering Command  
Page 4

Harding Lawson Associates

- Concern was expressed by Mr. Eagle that differential settlement could occur and cause the impervious cover to crack. Since the debris has been in-place from several to many years and much of the fill is under water, the tendency for abrupt differential settlement which would cause cracking is low. Settlement is expected to be relatively uniform except in the zone adjacent to the existing dredge pond. Some gradual differential settlement will occur in this zone along the boundary but it should not be abrupt.

We do not believe that cracking as a result of differential settlement is a major concern. However, cracking might occur as a result of shrinkage cracks forming in the impervious cap prior to the use of the pond. If this happens, the surface of the pond should be disced to close the cracks and surface rolled to compact it. If impervious soils are the first dredged materials to be placed in the pond, the impervious soil cap will be increased by the thickness of the deposited soil.

- Concern has been expressed about the material to be used for the impermeable cap and that water from the dredging would penetrate the cap. The design specifications require that the permeability of the soil cap will be  $1 \times 10^{-6}$  cps or less. It is assumed that the Navy will have inspectors on the job during construction to see that the design criteria are achieved.

The second concern can be alleviated by limiting the type and depth of material to be first placed in the pond on top of the impermeable cap. This concept is illustrated by the curves on the attached plate. For example, to protect the subsurface from infiltration of dredge water, the thickness of slurry and duration of the dewatering period can be controlled. Assuming a steady-state condition\* in the dredged pond with a water head of 6 feet, it would take 60 days for the water to completely penetrate the cap.

---

\*Steady-state condition is one where the outflow of water from the dredge pond equals the inflow of water and hence the water head remains constant. This is the system planned for the landfill when it is used as a dredged spoil disposal site.

April 26, 1983  
2176,059.01  
Commanding Officer, Western Division  
Naval Facilities Engineering Command  
Page 5

Harding Lawson Associates

Under actual conditions the free water would have been drained off the slurry within 30 days and the water head would be ever decreasing as drying occurs. At some point drying of the surface will cause capillary tension to completely remove the effect of the water head from the cap.

- ~~The closure plan does not contain supporting data to show that water drained from the dredged materials can meet standards for discharge and suspended solids because the source or sources of the material to be dredged is unknown at this time. Each source will be taken on a case-by-case basis and examined to determine if the water from the dredging can be discharged back into the bay.~~ Based upon our experience at numerous dredged spoil disposal sites on land, this project should not pose any significant problems in meeting water quality standards. The closure report does state that water will meet the State standards.
- ~~The methods of constructing the dredged disposal area dikes were not discussed in the closure report, but are discussed in detail in the Solid Waste Disposal Plans dated February 5, 1982.~~

The disposal area is located with a sufficient setback from the sea wall so that its influence on the sea wall stability is relatively small. The computed static factor of safety for the sea wall/dike configuration is 1.7. A pseudostatic analysis using a 0.1 g horizontal force gives a factor of safety of 1.2. Therefore, the horizontal force required to obtain a factor of safety of 1.0 is greater than 0.1 g. As explained below, the fact that the pseudostatic factor of safety is less than 1.0 does not mean that failure will occur.

During a large earthquake and a maximum credible earthquake along the Hayward fault, the bedrock acceleration may reach 0.3 g and 0.4 g, respectively. However, some attenuation will occur because of the plastic soils underlying the site. Dynamic analyses performed for sites around San Francisco Bay indicate that during the cyclic loading resulting from an earthquake, lateral displacement occurs only for short periods of time. The stresses induced in the embankment by an earthquake will exceed the strength of the embankment momentarily. The total extent

April 26, 1983

2176,059.01

Commanding Officer, Western Division

Naval Facilities Engineering Command

Page 6

of the movement will be limited by reversals in the direction of the earthquake force. The severity of the earthquake determines both the amount of movement which may occur with each reversal in loading and the number of reversals which are likely to occur. Therefore, lateral yielding of the slope can occur.

To actually determine how much movement would occur during a given earthquake, it would be necessary to perform a dynamic analysis. Based on our experience with dynamic analyses in the area, we judge that the lateral displacement during a large earthquake and a maximum credible earthquake would be less than one foot and as much as several feet, respectively. However, neither of these conditions necessarily defines failure. Failure would be defined by a complete collapse of the sea wall structure which would allow the sea water to enter the landfill area.

In summary, Mr. Eagle has raised some pertinent questions which we have answered. It is our opinion that, if sound engineering practices are followed, the closed landfill can be used satisfactorily for a dredged disposal facility.

Yours very truly,

HARDING LAWSON ASSOCIATES



Lyle E. Lewis,  
Civil Engineer - 16360

LEL/JCD/jd

Attachments

3 copies submitted

APR 11 1983

# ANALYTICAL SCIENCE ASSOCIATES, Inc.

4560 HORTON ST. • EMERYVILLE, CA 94608 • (415) 547-6390

HLA Project No. 2176,059.01

April 1, 1983

## ABSTRACT

Samples were received from the Alameda Naval Air Station on March 16 and 17 for the screening of Priority Pollutants. No contaminants were detected in the volatile or Base-Neutral fraction. The acid and pesticide fractions contained traces of phenol and polychlorinated biphenyls. No metals were detected above 1 ppm.

## METHODS

### I Volatile Fraction

Samples were analyzed by gas-chromatography<sup>(1,2)</sup> for the volatile priority pollutants using GCFID and GCHSD under the following analytical conditions:

Instrument	:	Perkin Elmer 3B
Column	:	SP 1000/Carbopack B
Program	:	50 <sup>0</sup> -200 <sup>0</sup> @ 8 <sup>0</sup> /minute

### II Base Neutral/Acid Fraction

Samples were analyzed by GCFID under the following analytical conditions:

Instrument	:	Perkin Elmer 3920
Column	:	1% SP2150 DB; Tenax 60/80
Program	:	50 <sup>0</sup> -270 <sup>0</sup> @ 8 <sup>0</sup> /minute; 180 <sup>0</sup> -300 <sup>0</sup>

**RECEIVED**APR 11 1983  
HARDING LABORATORY ASSOC.

### III Pesticide Fraction

The 6, 15 and 50 percent Florisil fractions were analyzed<sup>(3)</sup> by GCHSD under the following conditions:

Instrument	:	Perkin Elmer 3B
Column	:	3% OV1
Temperature	:	180°C

### IV Metals

Samples were filtered (0.45 um) and analyzed by Atomic Absorption spectroscopy.

## RESULTS

Data are presented in Table I. Only the actual organic components found have been reported.

- 
1. 40 CFR, part 141 app. C
  2. Sampling and Analysis Procedures for the Screening of Industrial Effluents. EPA 1979
  3. Methods for the Organic Analysis of Water and Wastes. EPA 1980.

LANDFILL WELL NO.	TABLE I							
	17	18	3	19	9	8	near 6	near 12
Sample ID	9001	9002	9003	9004	9005	9006	9007	9008
Cadmium	0.053	0.03	0.024	0.024	0.018	0.011	0.012	0.009
Copper	0.72	0.06	0.06	0.04	0.04	0.03	0.06	0.08
Lead	0.17	0.09	0.07	0.05	0.06	0.06	0.07	0.06
Selenium	0.08	0.04	0.03	0.04	0.04	0.04	0.03	0.04
Silver	k0.05	k0.05	k0.05	k0.05	k0.05	k0.05	k0.05	k0.05
Zinc	0.48	0.13	0.038	0.032	0.16	0.013	0.044	0.076
Oil & Grease	30	20	15	50	80	40	20	15
Phenol (ppb)	26	11	k10	k10	11	10	11	10
TICH (ppb, as arochlor 1248)	0.52	0.08	0.05	0.60	0.40	k0.05	0.20	0.10
Arsenic	0.09	0.06	0.05	0.06	0.04	0.04	0.05	0.05
Beryllium	0.012	k0.01	k0.01	k0.01	k0.01	k0.01	k0.01	k0.01
pH	7.4	7.0	7.3	7.1	7.2	7.2	7.5	7.7
Conductivity	6400	19,000	13,000	16,000	2700	3500	1500	1300
Nickel	0.11	0.11	0.10	0.13	0.12	0.07	0.06	0.07



All values in ppm unless otherwise noted.

ADDENDUM

LANDFILL WELL NO.	17	18	3	19	9	8	near 6	near 12
Sample ID	9001	9002	9003	9004	9005	9006	9007	9008
Chromium	k0.05	k0.05	k0.05	k0.05	k0.05	k0.05	k0.05	k0.05
Mercury	0.0008	k0.0001	k0.0001	k0.0001	0.0002	k0.0001	k0.0001	k0.0001
Magnesium	120	420	420	420	57	68	33	35

All values in ppm unless otherwise noted.

k = less than value

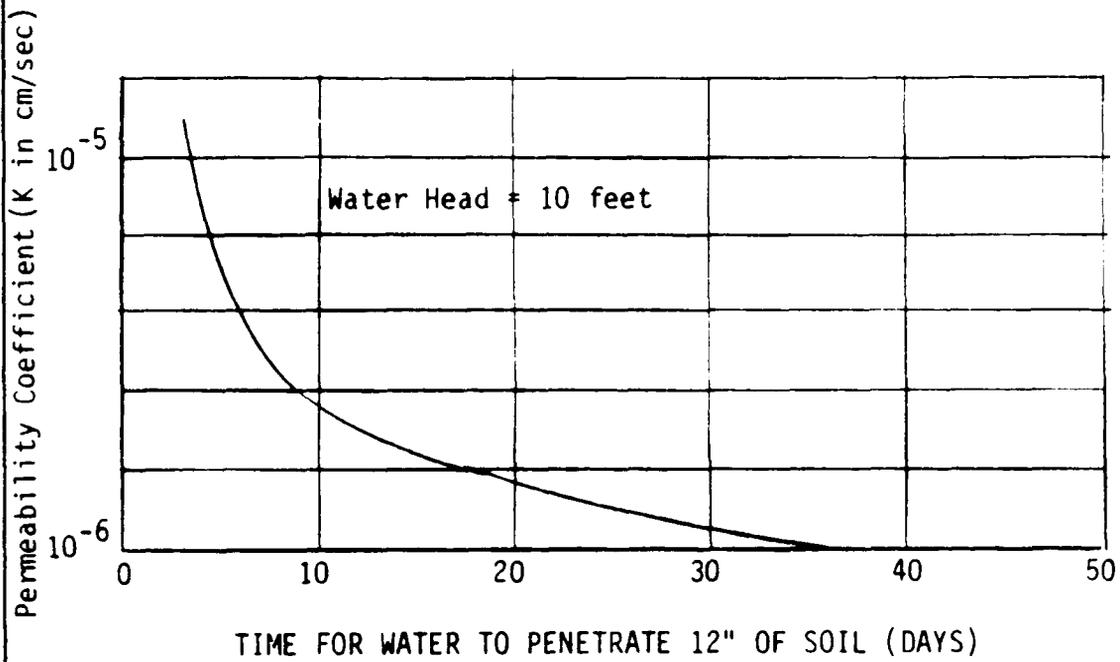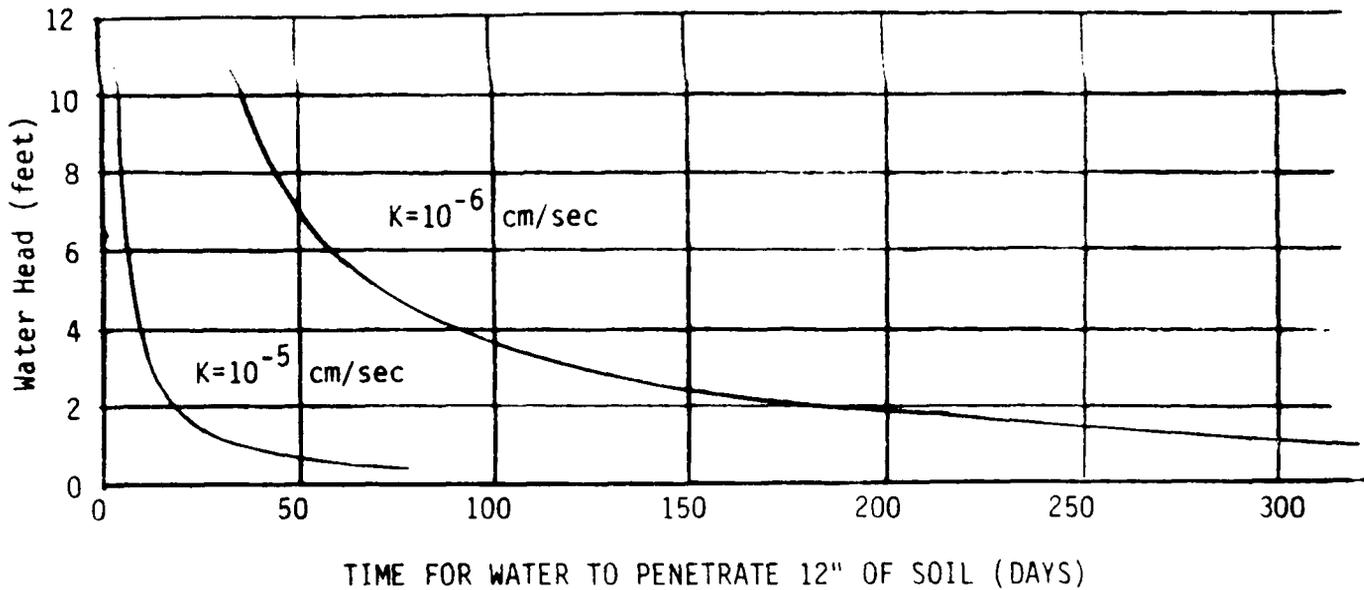

**HLA** **Harding Lawson Associates**  
 Engineers, Geologists  
 & Geophysicists

TIME FOR WATER TO PENETRATE 12" OF SOIL  
 Sanitary Landfill  
 NAS Alameda, California

PLATE  
**A**



April 13, 1983

2176,059.01

Commanding Officer  
Western Division  
Naval Facilities Engineering Command  
P. O. Box 727  
San Bruno, California 94066

Attention: Code 405  
Mr. James Washington

Gentlemen:

This letter presents the results of Harding Lawson Associates' (HLA) ground-water sampling and water chemistry testing for the Alameda Naval Air Station landfill which has been inactive since about 1977.

BACKGROUND

Starting in 1976, HLA has performed various studies of the landfill and its operations. The results of those studies were summarized in our report dated March 1, 1978. In 1982, HLA completed plans and specifications for closing the landfill which included constructing dikes and weirs so that the area could be used for the disposal of dredged materials.

Prior to our recent assignment, water quality monitoring was performed by HLA in 1976 and 1977 for our March 1978 report. The water samples were tested for parameters normally associated with sanitary landfills which were of concern to the California Regional Water Quality Control Board at that time. The only parameters relevant to this assignment were the heavy metals and oil and grease.

RECEIVED  
APR 18 1982  
IN CODE 405

April 13, 1983  
2176,059.01  
Western Division  
Naval Facilities Engineering Command  
Page 2

Recently, a draft copy of the Initial Assessment Study (IAS) of Naval Air Station, Alameda, California, dated February 1983, by Ecology and Environment, Inc., was available for review. It indicated that large quantities (405,000 tons) of solvents, oil, and heavy metals were among many possible contaminants which may have been placed in the landfill during its existence. Our letter of March 2, 1983, provided initial review comments of the IAS study. In our letter, we recommended that as many of the existing monitoring wells in the landfill that could be found be sampled and water quality tests be performed to indicate if the alleged materials were present in the landfill in sufficient quantity to be of concern.

As the IAS report was to be published in final form early in April of 1983, the work was to be completed quickly so that the results could be used in the report. This necessitated a rapid field sampling and testing program.

#### SAMPLING AND TESTING

Since 1977, some minor grading has been done and some dredged sand has been placed in the southerly portion of the site. During the grading, apparently some of the monitoring wells were destroyed. In addition, some wells could not be located because they were either under water or hidden by high grass which covers much of the site. For these reasons, we were only able to locate six of the original 15 observation wells. Samples also were taken from water which was ponded in the area of Observation Wells 6 and 12.

The sampling was performed on March 16 and 17, 1983. Prior to sampling each observation well, at least five well volumes of subsurface water were withdrawn. The water samples were placed in containers\* such that the head space was zero to prevent the loss of any volatile constituents. At the end of each day, the samples were taken to Analytical Science Associates (ASA) of Emeryville, California, for laboratory testing using chain of custody procedures. The testing included gas chromatograph scans for the Environmental Protection Agency's list of 129 priority pollutants. On March 31, 1983, the results were transmitted to you by telephone. A copy of the ASA test report with well numbers added is attached.

---

\*40 milliliter glass vial, 1 liter glass bottle and 250 milliliter plastic bottle.

April 13, 1983  
2176,059.01  
Western Division  
Naval Facilities Engineering Command  
Page 3

Harding Lawson Associates

#### CONCLUSIONS

We have reviewed the test data and compared it, where possible, to the previous test data from the monitoring wells. Although less than half of the wells were located and sampled, the results of the samples taken from the widely scattered observation wells indicate that:

1. The heavy metal concentrations are about the same as they were in 1977 (all less than one part per million)
2. No volatile or base neutral fractions were detected
3. The acid fraction contained only a trace of phenol
4. The total identifiable chlorinated hydrocarbon (TICH) fraction indicated a slight trace of PCB

Based on this analysis, it does not appear that significant amounts of materials are present in the landfill at hazardous levels.

If you have questions concerning our work or wish us to discuss the results with you, please call.

Yours very truly,


HARDING LAWSON ASSOCIATES

*Lyle E. Lewis*  
Lyle E. Lewis,  
Civil Engineer - 16360


LEL/JCD/jd

5 copies submitted

cc: NEESA  
Port Hueneme, California 93043  
Attention: Code 112N John Accardi  
Building 835, Wing 2 Room 200F

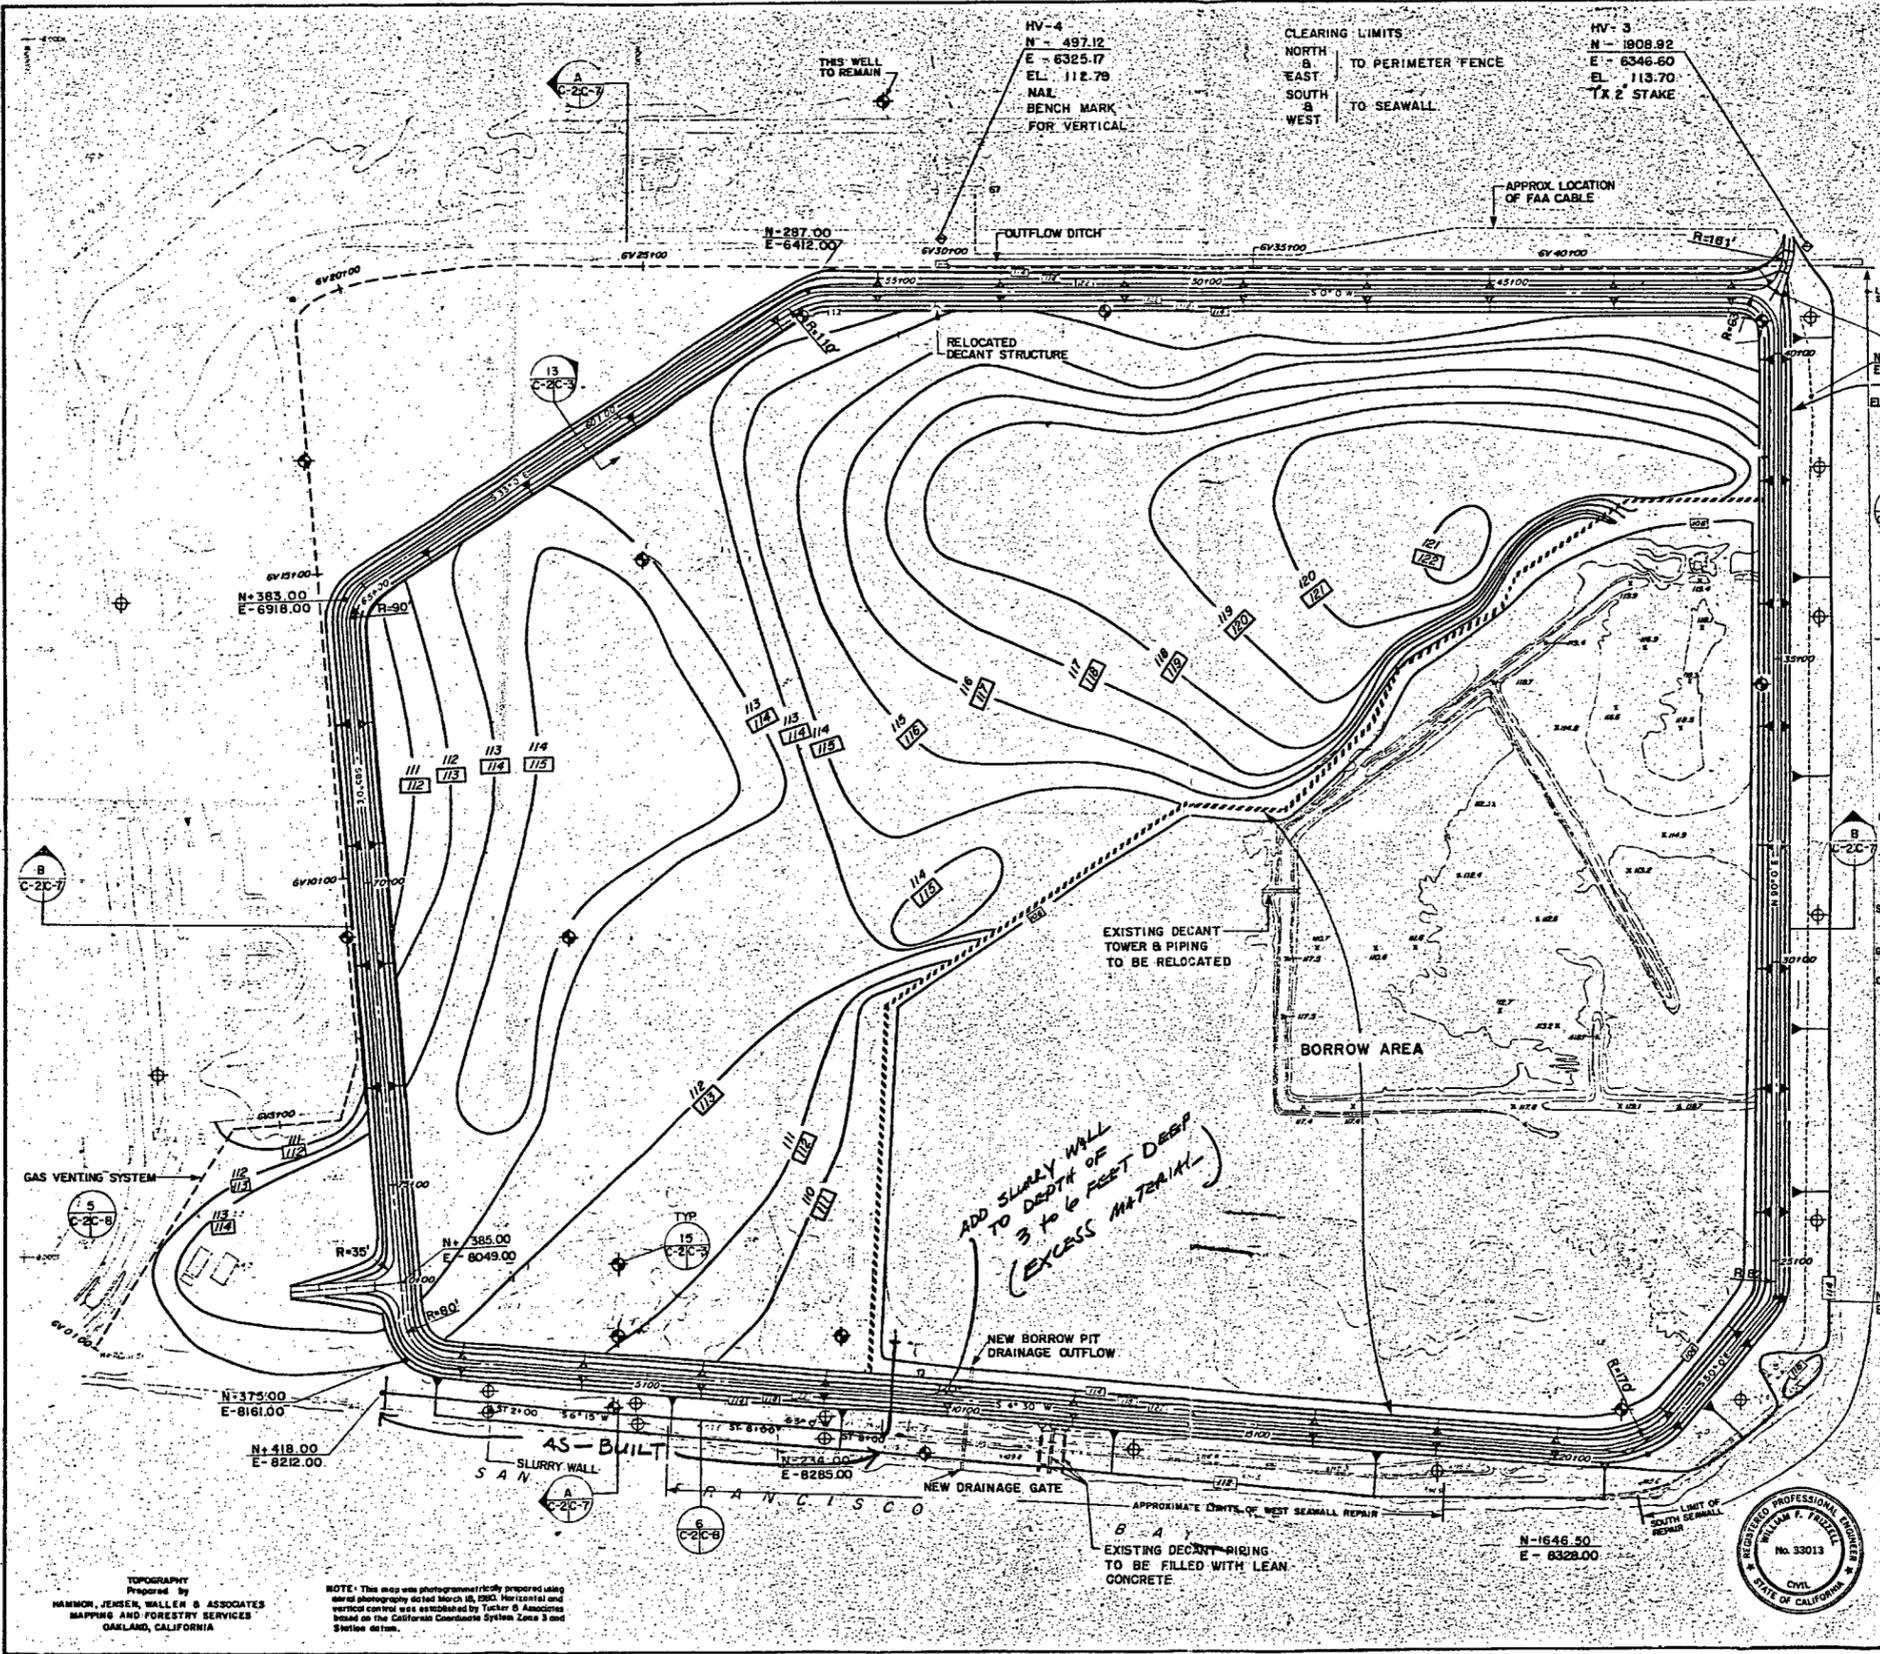


REVISIONS				
NO.	DESCRIPTION	PREP'D BY	DATE	APPROVED

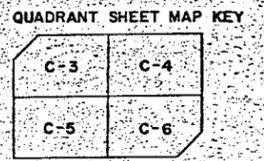

- LEGEND
- DETAIL OR SECTION NUMBER SHEET ON WHICH DETAIL OR SECTION IS SHOWN SHEET FROM WHICH DETAIL OR SECTION IS TAKEN
  - APPROXIMATE LOCATION OF NEW WATER MONITORING WELLS CONTRACTOR TO GET EXACT LOCATION TO BE VERIFIED BY OICC
  - APPROXIMATE LOCATION WATER MONITORING WELLS TO BE REMOVED
  - GAS VENTING SYSTEM LOCATION
  - LEVELING COURSE CONTOURS (AFTER LEVELING)
  - FINISHED GRADE CONTOURS
  - EXISTING CONTOURS
  - HV-30 SURVEY CONTROL MONUMENTS
  - APPROXIMATE BOUNDARY BETWEEN REFUSE AREA AND DREDGE SPOILS AREA
  - APPROXIMATE LOCATION OF FAA CABLE (MARKERS PROVIDED AT CHANGES IN DIRECTION)
  - DIKE STATIONING
  - SLURRY TRENCH STATIONING - EXACT LOCATION TO BE DETERMINED IN FIELD DURING CONSTRUCTION
  - GAS VENTING STATIONING
  - OUTFLOW DITCH STATIONING
  - EXISTING SPOT ELEVATION

- LIST OF ABBREVIATIONS
- C. TO C. = CENTER TO CENTER
  - CL = CENTERLINE
  - CMP = CORRUGATED METAL PIPE
  - EL. = ELEVATION
  - GA. = GAGE
  - R = RADIUS
  - TYP. = TYPICAL
  - Ø = DIAMETER

**AS BUILT**  
 CHANGES AS NOTED  
 NO CHANGES  
 CONTRACTOR'S CHECKED BY  
 SUPERVISOR'S CHECKED BY  
 DATE: MAR 85

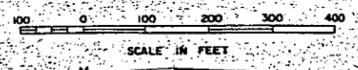

IF SHEET IS LESS THAN 28" X 40" IT IS A REDUCED PRINT - SCALE REDUCED ACCORDINGLY

**C-2**


TOPOGRAPHY Prepared by HANMON, JENSEN, MILLER & ASSOCIATES, MAPPING AND FORESTRY SERVICES, OAKLAND, CALIFORNIA

NOTE: This map was photogrammetrically prepared using aerial photography dated March 16, 1982. Horizontal and vertical control was established by Tucker & Associates based on the California Coordinate System Zone 3 and Station datum.




HARDING LAWSON ASSOCIATES Consulting Engineers and Geologists DESIGN: WFF, DR. [ ] SUPV.: AJW, [ ] DRAWN BY: [ ] CHECKED BY: [ ] DATE: 2/15/85 SCALE: AS SHOWN	DEPARTMENT OF THE NAVY NAVAL FACILITIES ENGINEERING COMMAND WESTERN DIVISION SAN DIEGO, CALIFORNIA ALAMEDA HAS ALAMEDA, CALIFORNIA P 183 SOLID WASTE DISPOSAL SYSTEM GENERAL PLAN DRAWING NO. 6161496 CODE: 80091 CONTRACT NO. M42474-BC-8054 SHEET 3 OF 10
---	--

REVISIONS				
NO.	DESCRIPTION	DATE	BY	APPROVED

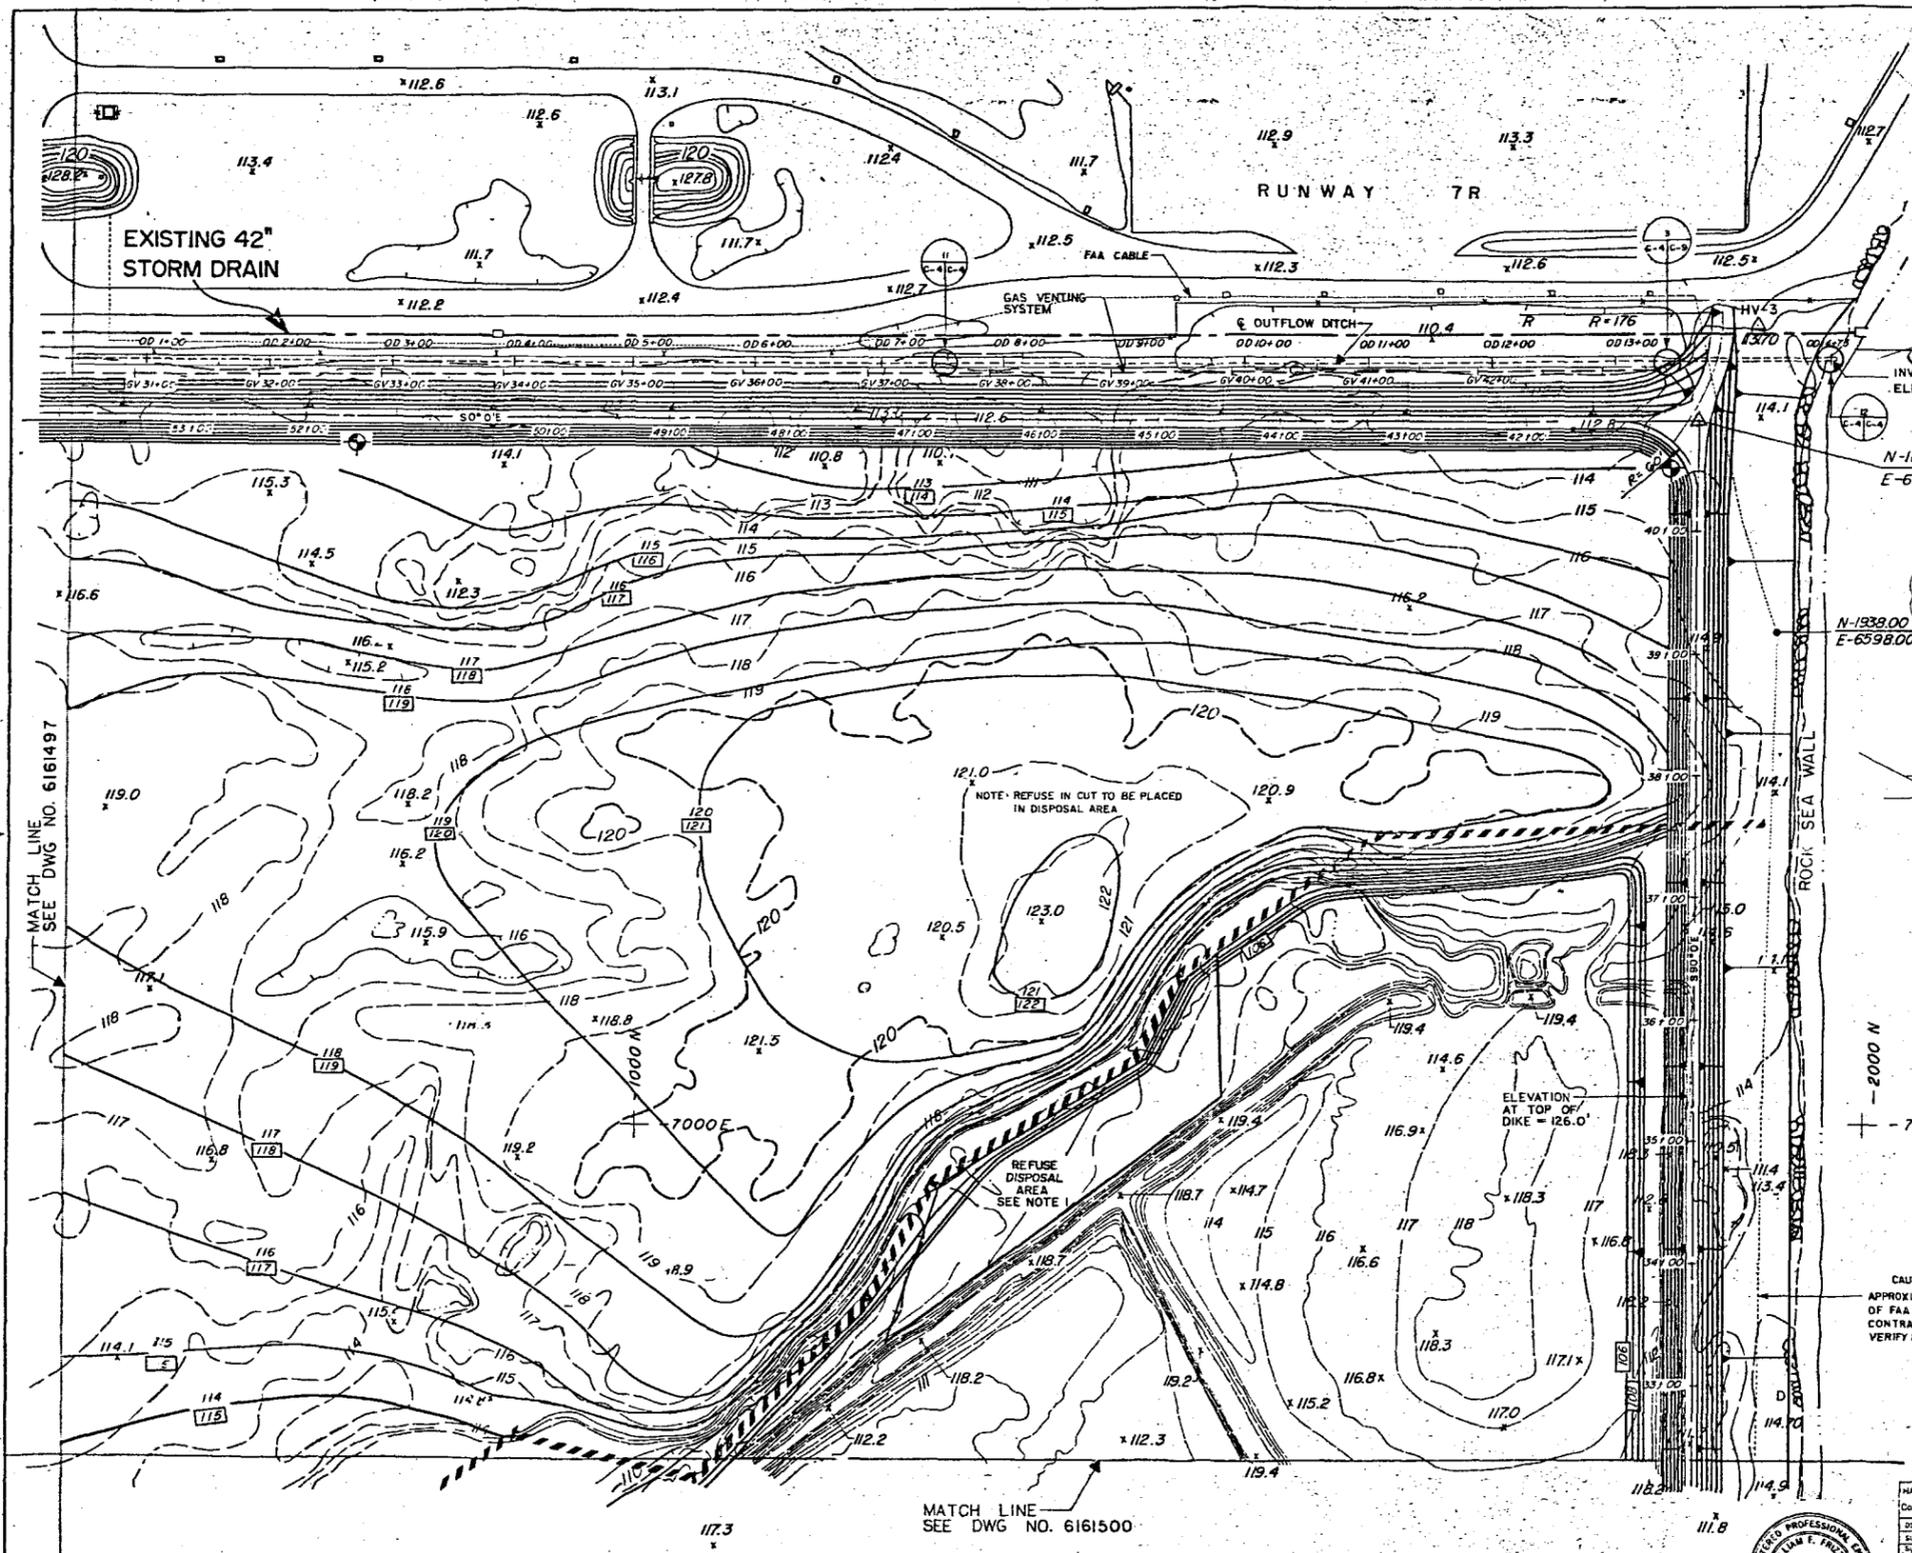


- NOTES:
- Borrow material to be excavated before placing refuse in refuse disposal area.
  - Top of dike is of elevation 126'. Contour interval on dike slopes is 2'.

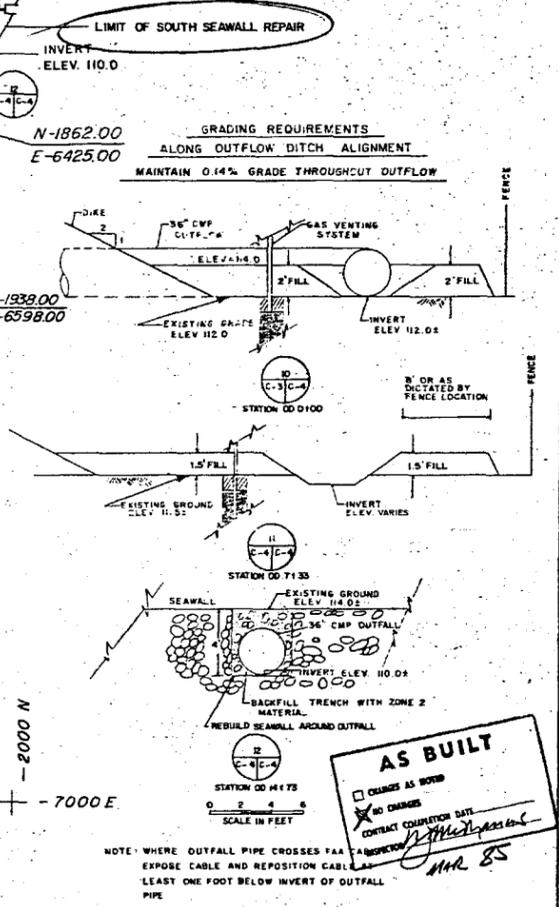

**AS BUILT**

NO CHANGES  
NO CHANGES  
CONTRACT COMPLETION DATE: 2/15/82  
MHR 85

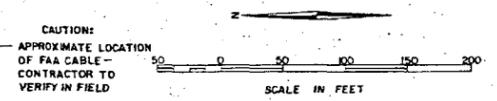

IF SHEET IS LESS THAN 28" X 40" IT IS A REDUCED PRINT - SCALE REDUCED ACCORDINGLY

**C-4**

TOPOGRAPHY  
Prepared by  
HAMMON, JENSEN, WALLEN & ASSOCIATES  
MAPPING AND FORESTRY SERVICES  
OAKLAND, CALIFORNIA


NOTE: This map was photogrammetrically prepared using aerial photography dated March 10, 1960. Horizontal and vertical control was established by Tache & Associates based on the California Coordinate System Zone 3 and Station 50 Lum, Mean Lower Low Water + 102.2 feet.

This map was extracted from the original topographic map scale 1"=100', contour interval 1'.



HARDING-LAWSON ASSOCIATES Consulting Engineers and Geologists DISA WFF   DR   CHA WFF SUPV JLN   CHA ENGR JCD DATE 2/15/82 PROJECT SOLID WASTE DISPOSAL SYSTEM No. 33023 CIVIL STATE OF CALIFORNIA	DEPARTMENT OF THE NAVY NAVAL FACILITIES ENGINEERING COMMAND WESTERN DIVISION SAN BRUNO, CALIFORNIA
ALAMEDA NAS ALAMEDA, CALIFORNIA P183 SOLID WASTE DISPOSAL SYSTEM PLAN - S.E. QUADRANT.	
DATE 2/15/82 DRAWN BY WFF CHECKED BY JCD	SCALE 1"=100'
SIZE F CODE IDENT. NO. 80091 DATE	NAVFAC DRAWING NO. 6161498 CONST. CONTR. NO. N6241-80-9054 SHEET 3 OF 10


ADDED UP AS-BUILTS FOR U.S. DIV

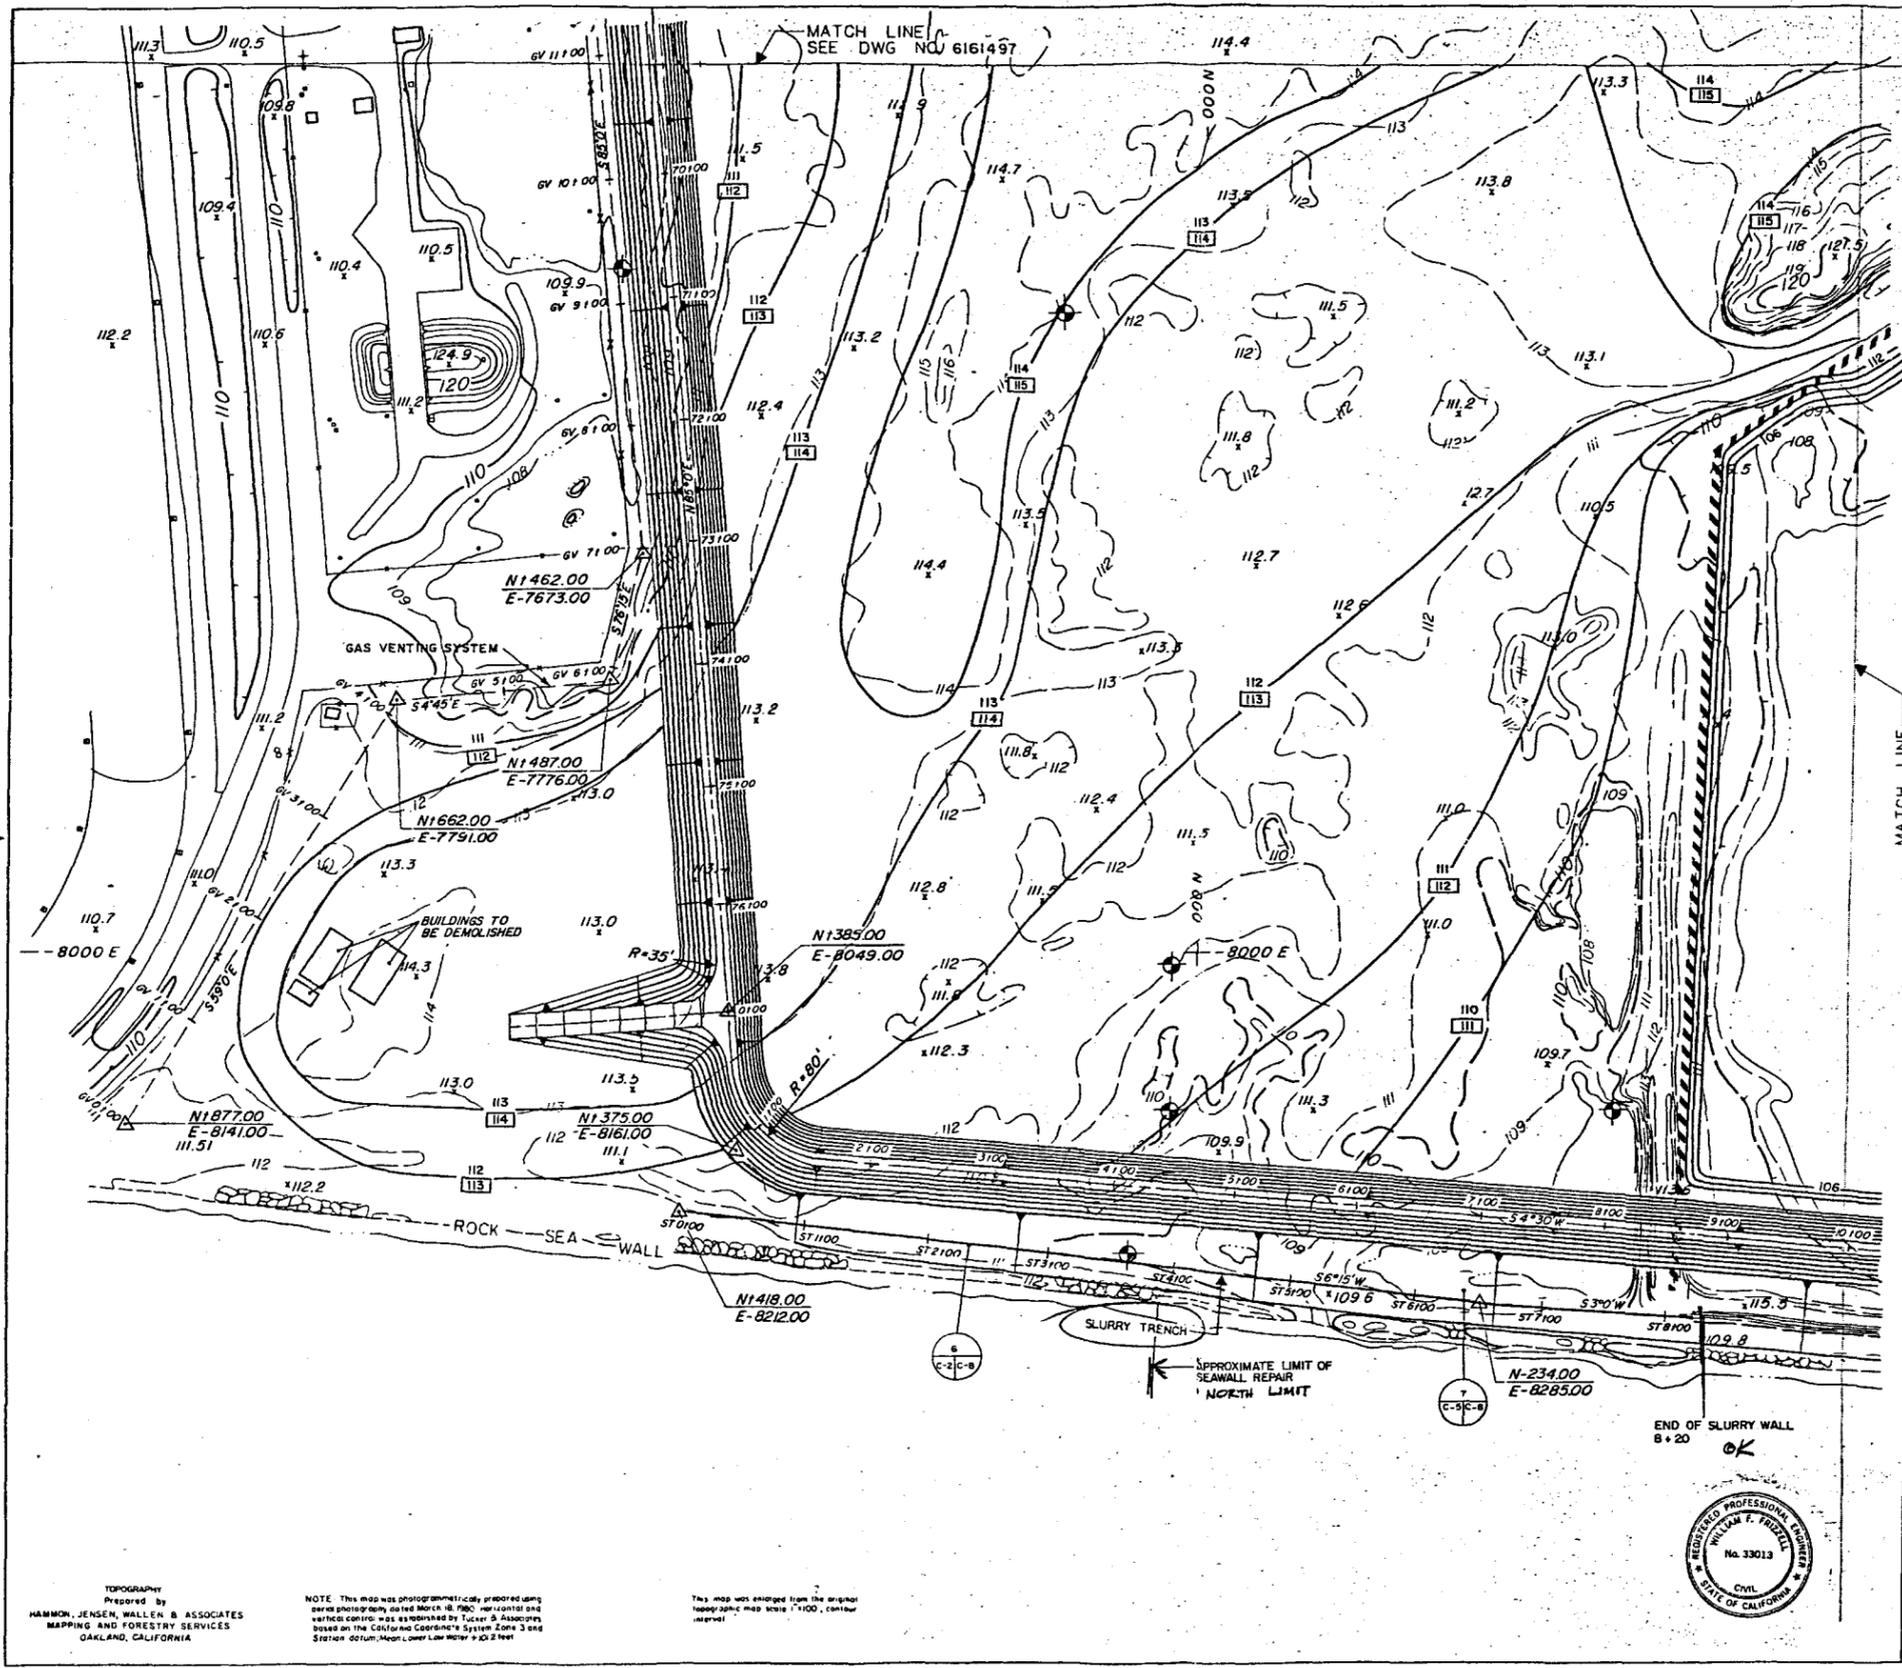

REVISIONS			
NO.	DESCRIPTION	PREPARED BY	DATE

NOTE:  
Top of dike at elevation 126'. Contour interval on dike slopes is 2'.

**AS BUILT**  
 X CHANGES AS NOTED  
 NO CHANGES  
 CONTRACT COMMENCEMENT DATE  
 INSPECTOR: *[Signature]*

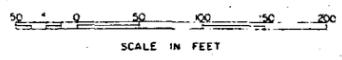

IF SHEET IS LESS THAN 28" X 40"  
IT IS A REDUCED PRINT —  
SCALE REDUCED ACCORDINGLY

**C-5**


TOPOGRAPHY  
Prepared by  
**HAMMON, JENSEN, WALLER & ASSOCIATES**  
MAPPING AND FORESTRY SERVICES  
OAKLAND, CALIFORNIA

NOTE: This map was photogrammetrically prepared using aerial photography, dated March 18, 1960. Horizontal and vertical control was established by Tucker & Associates, based on the California Coordinate System, Zone 3 and Station datum: Mean Lower Low Water + 2.2 feet.

This map was enlarged from the original topographic map scale 1"=100', contour interval.






HARDING-LAWSON ASSOCIATES Consulting Engineers and Geologists		DEPARTMENT OF THE NAVY WESTERN DIVISION SAN BRUNO, CALIFORNIA	
DESIGN WFF: DR	CHE. WFF	ALAMEDA NAS ALAMEDA, CALIFORNIA	
SUPV. WFF: WFF	CHK. ENGR: JCD	P 183	
DESIGNED BY: WFF	DATE: 2/3/82	SOLID WASTE DISPOSAL SYSTEM	
ENGR. WFF: WFF	DATE: 2/3/82	PLAN - N.W. QUADRANT	
DATE: 2/3/82	SCALE: AS SHOWN	NAVAFAC DRAWING NO.: 6161499	CONTRACT NO.: 182244-80-C-9034
APPROVED: WFF	DATE: 2/3/82	SHEET 6 OF 10	

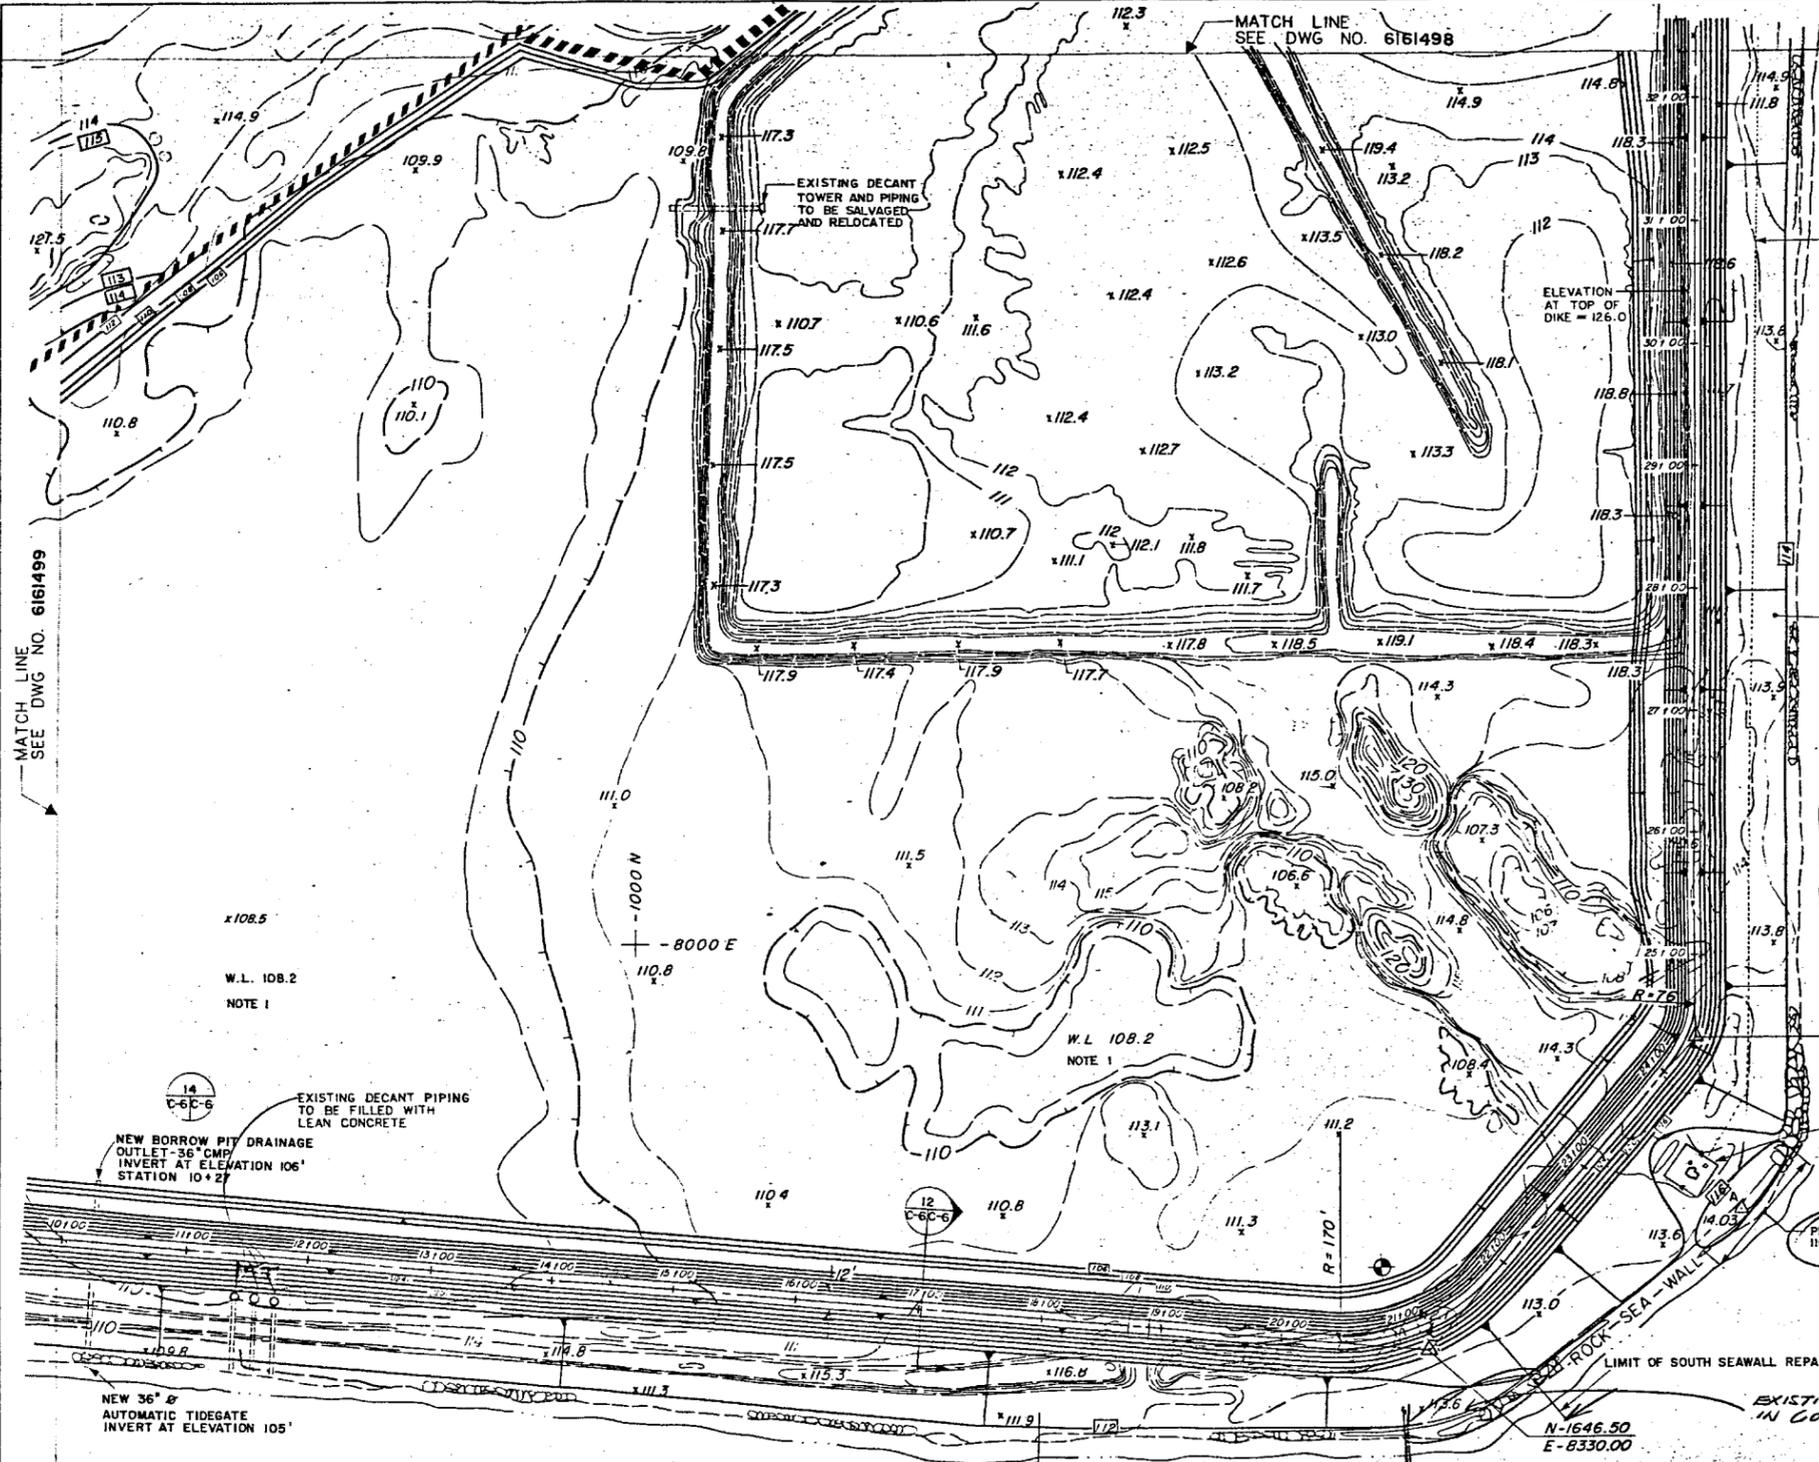

REVISIONS			
NO.	DESCRIPTION	PREP BY	DATE APPROVED

- NOTES
1. Water level show is due to ponding from rainfall. The elevations of the ground water at time of drilling was about 106'.
  2. Top of dike at elevation 126'. Contour interval on dike slopes is 2'.

CAUTION: APPROXIMATE LOCATION OF FAA CABLE - CONTRACTOR TO VERIFY IN FIELD.

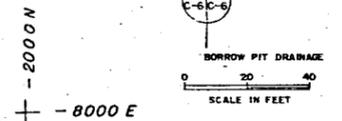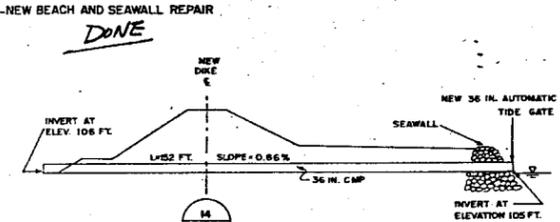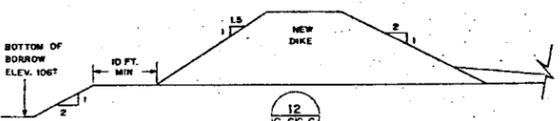

**AS BUILT**  
 \* CHANGES AS NOTED  
 NO CHANGES  
 CONTRACTOR'S DATE  
 INSPECTOR: *[Signature]*

FAA OUTER FACILITY MARKER DO NOT DISTURB

PROVIDE RIPRAP TO ELEVATION 116' IN THIS AREA



MATCH LINE SEE DWG NO. 6161499

MATCH LINE SEE DWG NO. 6161498

TOPOGRAPHY Prepared by HAMMON, JENSEN, WILHELM & ASSOCIATES, OAKLAND, CALIFORNIA

NOTE: This map was photogrammetrically prepared using aerial photographs dated March 8, 1960. Horizontal and vertical control was established by Tucker B. Associates based on the California Coordinate System Zone 3 and Station Datum, Mean Lower Low Water + 104.2 feet.

This map was prepared from the original topographic map scale 1:100, contour interval




CONTRACTOR STRAIGHTENED AND REPAIRED RIP RAP TO THIS LIMIT 3/15/85

HARDING-LAWSON ASSOCIATES Consulting Engineers and Geologists 2500 W. 11th St. Berkeley, CA 94710	DEPARTMENT OF THE NAVY NAVAL FACILITIES ENGINEERING COMMAND WESTERN DIVISION SAN BRUNO, CALIFORNIA
DESIGN: WFF/DR DRAWN: JLV CHECKED: WFF/DR DATE: 2/5/82 BY: WFF/DR	ALAMEDA NAS ALAMEDA, CALIFORNIA P183 SOLID WASTE DISPOSAL SYSTEM PLAN - S.W. QUADRANT
DATE: 7-11-85	SCALE: AS SHOWN
CODE IDENT. NO. 80091	NAVAL DRAWING NO. 6161300
CONTRACT NO. W600-80-9054	SHEET 7 OF 10

C-6


IF SHEET IS LESS THAN 28" X 40" IT IS A REDUCED PRINT - SCALE REDUCED ACCORDINGLY

REVISIONS				
NO.	DESCRIPTION	DATE	BY	APP'D

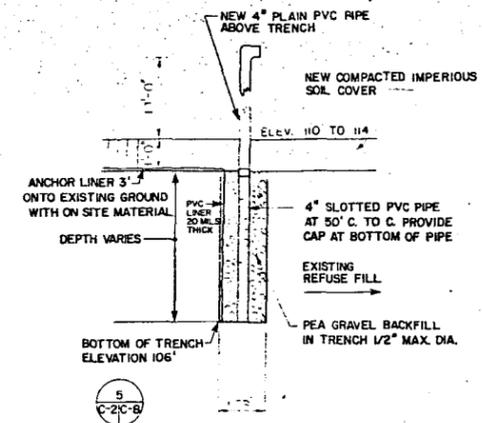


DETAIL — PERIMETER GAS VENTING SYSTEM

SCALE IN FEET

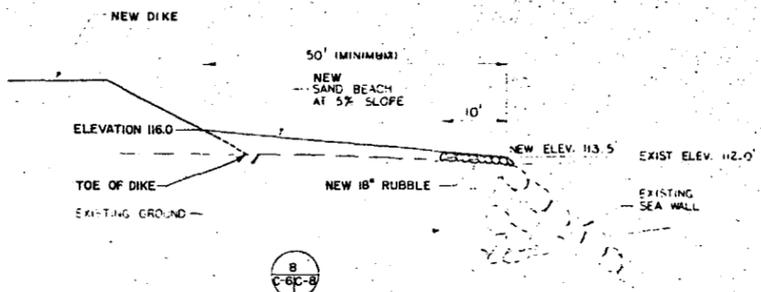

DETAIL — SLOPE REPAIR — SOUTH SEA WALL


SCALE IN FEET

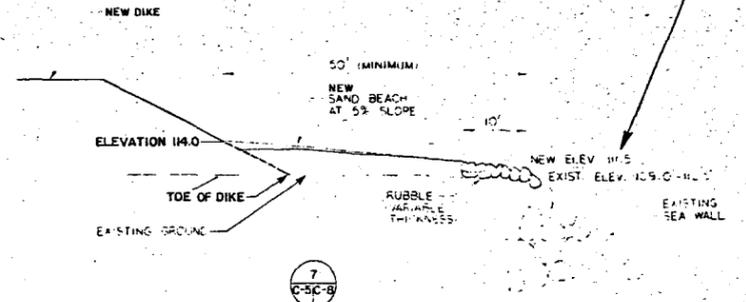

DETAIL — SLOPE REPAIR — WEST SEA WALL

SCALE IN FEET

NOTE:  
REPAIR WORK SHALL BE DONE ONLY UP TO ELEVATION 111.5

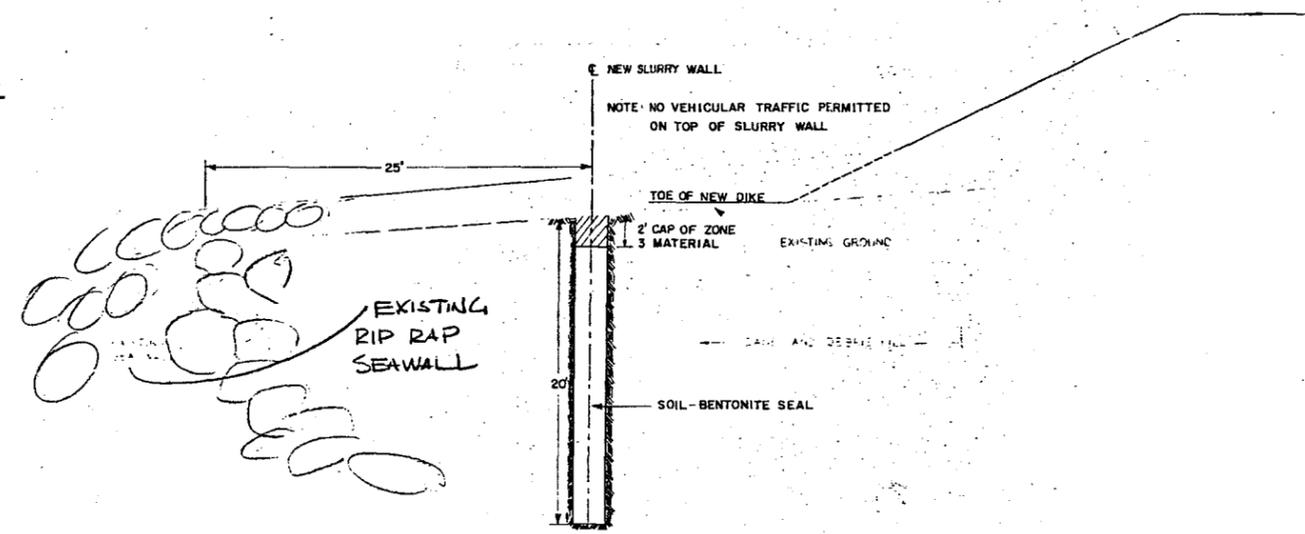

DETAIL — SEEPAGE CONTROL SLURRY WALL

NOT TO SCALE

**AS BUILT**  
 CHANGES AS NOTED  
 NO CHANGES  
 CONTRACT COMPLETION DATE: *11/18/88*  
 INSPECTOR: *[Signature]*



HARDING LAWSON ASSOCIATES Consulting Engineers and Geologists		WESTERN DIVISION	
DR. WFF	DR. TL	DR. WFF	DR. WFF
DR. JLM	DR. JCB	DR. JLM	DR. JCB
ALAMEDA, CALIFORNIA		ALAMEDA, CALIFORNIA	
P 183		P 183	
SOLID WASTE DISPOSAL SYSTEM		SOLID WASTE DISPOSAL SYSTEM	
SCALE: AS SHOWN		SCALE: AS SHOWN	
DATE: 7-11-88	DATE: 7-11-88	NO. 80091	NO. 6161502
SCALE: AS SHOWN	SCALE: AS SHOWN	SCALE: AS SHOWN	SCALE: AS SHOWN

C-8