



DEPARTMENT OF THE NAVY  
NAVAL AIR STATION  
MOFFETT FIELD, CALIFORNIA 94035

IN REPLY REFER TO

183:KET:jlh

11000

Ser 1 2329

OCT 28 1982

Mr. Fred H. Dierker, Executive Officer  
California Regional Water Quality Control Board  
San Francisco Bay Region  
1111 Jackson Street, Room 6040  
Oakland, California 94607

Dear Mr. Dierker:

In accordance with your letter of 30 September 1982, the enclosed scope of work with attachments for a subsurface investigation program is submitted for your approval. It is requested that comments and/or approval for the program be forwarded by phone to expedite implementation of the program. A subsequent letter of approval is requested.

The subsurface investigation program will be conducted by contract through an architect/engineering firm. As you are well aware of, there are numerous underground tanks, waste and non-waste storage, on the Naval Air Station and additional time is required to ensure the results of the subsurface investigation program are accurate and the procedures in the scope of work are followed. Accordingly, the final report on the results of the program will be submitted by 15 December 1982.

Sincerely,

CDR, USN

Public Works Officer

By direction of the

Commanding Officer

Encl:

- (1) Scope of Work for a Subsurface Investigation Program
- (2) Map of Naval Air Station
- (3) NAS Moffett Field, Public Works Drawing No. 323-516-1 thru 323-516-8

Copy to:

Western Division, Naval Facilities Engineering Command  
(Attn: M. Yao, Code 1142)

5

NAVY/RWQCB 3

I. Scope of Work:

Engineering Services are required to conduct a subsurface investigation program in accordance with ITEMS II-IV. The subsurface investigation program includes construction of monitoring wells, soil sampling, water sampling, testing of samples, and submission of a final report.

II. MONITORING WELL CONSTRUCTION

a. Number of Monitoring Wells

(1) Individual sumps of tanks which includes:

<u>PURPOSE</u>	<u>TANK NO.</u>	<u>DESCRIPTION</u>	<u>LOCATION</u>	<u>GRID</u>
Fuel Stge	58	Day Tanks	Tank Truck Unloading Fac.	18V
" "	59	" "	" "	18V
" "	60	" "	" "	17V
" "	61	" "	" "	17V
" "	253	Day Tanks	Hi Spd Refuel	21BB
Waste Solvent	---	Ang, Hgr 3	NE Corner Hgr 3	19Z
Waste Solvent	---	ATND Power Plants	East Side Hgr 3	19X

(a) At least two wells within 10 feet of each end on the down gradient side of the tank.

(2) Closely spaced multiple tank or multiple sumps which includes:

<u>PURPOSE</u>	<u>TANK NO.</u>	<u>DESCRIPTION</u>	<u>LOCATION</u>	<u>GRID</u>
Fuel Stge	137-140	Bulk Fuel Stge	Fuel Farm #503	17Y/16Z
Fuel Stge	---	Nex Fuel Stge	Nex Serv. Sta	27R
Rinse Water	---	Flux Ponds	Near Bldg 524	19AA
Fuel Stge	---	Trans. Fuel Stge	Near Bldg 161	250
Fuel Stge	135-136	Working Tanks	Truck Loading Fac	17V

a. Wells along each side of the unit and within 10 feet of the unit as indicated on the attachments.

b. Each monitoring well shall be bored to a depth of 20 feet below the upper limit of the zone of saturation. However, monitoring wells shall not penetrate a competent (approximately 5 feet thick) clay layer below the zone of saturation.

c. Drilling with a hollow-stem, continuous-flight is preferable. If conditions do not permit the use of an auger, an air rotary drill with casing hammer can be used. In no cases will a conventional mud-rotary drill be allowed. Test holes shall be logged by a registered engineering geologist or registered geologist and shall be located on a site map which shows the location of all subsurface tanks, sumps and buried pipelines used to transport material to or from tanks and sumps.

d. Monitoring wells shall be drilled to accept a casing of 2 inch (inside diameter) minimum diameter.

e. Monitoring wells shall be cased with clean PVC casing. Cleaning shall be accomplished with trisodium phosphate (TSP) and water followed by thorough rinsing with water. Treaded joints will be used. PVC screened casing shall be installed within the entire saturated zone considering water table fluctuation. The entire perforated zone shall be gravel-paced with clean, washed pea gravel. The casing shall be cemented from the top of the perforated zone to the ground surface and an appropriate surface grout seal installed.

f. The casing shall extend at least one foot above the ground surface and be sealed to prevent contamination.

g. The well shall be extend at least one foot above the ground surface and be sealed to prevent contamination.

h. Each boring pursuant to II.A. shall include soil samples as follows:

(1) Samples shall be taken at depths of 5, 10, 20 and 30 feet below the lowest point of any sump or subsurface tank; however, no soil samples are required in the saturated zone.

(2) Samples shall be taken utilizing a Shelby Tube or Modified California sampler.

(3) Samples shall be immediately capped with teflon or aluminum.

(4) Samples shall not be extruded in the field but shall be immediately cooled according to current sample preservation requirements and extruded by and at certified laboratories.

i. If groundwater is not encountered within the first 30 feet below the lowest point of any sump or subsurface tank it is not necessary to complete the monitoring well. If a well is not completed the bore hole shall be sealed according to County Well sealing standards.

### III. MONITORING WELL SAMPLING

a. Water sampling shall be accomplished with a teflon or stainless bailer or submersible pump. Teflon shall be used for pump tubing.

b. The wells shall be bailed or pumped to remove 4 to 10 well volumes prior to sampling. If the well is evacuated before 4 to 10 well volumes are removed, then the sample shall be taken when the well recovers to approximately 80% of its initial water elevation. It is acceptable to use a peristaltic pump to remove this 4 to 10 well volumes; however, jetting shall not be used.

c. Two water samplings will be taken at a minimum of 7 calendar days apart.

d. Water samples shall be handled and preserved according to the latest EPA methods described in the Federal Register (Volume 44, No. 233, Monday December 3, 1979 pg 69544, table II) for the type of analysis to be performed.

### IV. LABORATORY ANALYSIS

a. All samples shall be analyzed by laboratories approved for the type of analysis to be performed. A list of approved laboratories is attached.

b. Monitoring well samples around underground tanks or sumps shall be analyzed for constituents stored in the tanks or held in the sumps as follows:

(1) Production grade (non-waste) constituents (tank storage).

(a) Water samples shall be analyzed according to EPA methods for all constituents which have ever been or are being stored in the tank. The following information shall be provided:

- 1 List of constituents held in tank;
- 2 EPA method(s) used to detect each constituent listed;
- 3 Limits of detection;
- 4 Section IV b.(1)(a) applies to all tanks listed under section II a.(1) except for the two waste solvent tanks and the flux ponds.

(b) If the nature of all constituents ever stored in the tank cannot be accurately determined then analysis of well samples shall include a complete priority pollutant scan (volatile organic, base/neutral extractables, acid extractables, pesticides/PCB's metals and cyanide) in which all peaks detected are identified. If specific groups of constituents can be accurately documented to have not been held in the tank; analysis for these group may be eliminated (e.g. if pesticides were never handled then the pesticide fraction may be eliminated). The following information shall be reported:

- 1 Rationale for eliminating any analysis;
- 2 EPA methods used;
- 3 Limits of detection.

(2) Waste tanks or sumps

(a) Follow procedures outlined in IV b.(1)(b) for the two waste solvent tanks and the flux ponds.

c. Soil samples around underground tanks or sumps shall be analyzed as described in the appropriate section of IV. b. above. Soil samples from the same bore hole may be composited on an equal volume basis prior to analysis. If analysis for volatile constituents are to be performed the compositing shall occur by taking equal volumes directly from each sample with a cork bore and placing these volumes directly into purge and trap apparatus.

V. REPORTS

a. A report shall be submitted to the Officer-in-Charge of Construction which will include:

- (1) Letter of transmittal;
- (2) Map showing locations of sumps, tanks and monitoring wells;
- (3) Monitoring well boring logs and as-constructed information;
- (4) Laboratory Data including laboratory procedures.

b. If the results of analysis under section IV. b. and c. indicate no detectable levels of constituents then the report will be submitted 30 calendar days from the contract award date.

c. If the results of the analysis under section IV. b. and c., indicate detectable levels of constituents then the Officer-in-Charge of Construction will be notified by phone immediately. An interim report will be submitted for the samples containing constituents within seven days of notification and will include all items identified in V. a. and an initial proposal to begin determining the vertical and lateral extent of the constituents. A report on the remaining samples will be submitted 30 days from the date of award.

Laboratories Approved For Organics

Acurex Analytical Chemistry  
Lab  
405 Clyde Avenue  
Mountain View, CA 94042

Anatec Laboratories Inc  
435 Tesconi Circle  
Santa Rosa, CA 95401

Anlab  
1914 S Street  
Sacramento, CA 95814

Antelope Valley - East  
Kern Water Agency  
P.O. Box 3176  
Quartz Hill, CA 93534

Associated Laboratories  
N. Gavavia  
Loge, CA 92668

Brown and Caldwell  
Environmental Sciences  
Division  
1255 Powell Street  
Emeryville, CA 94608

California Analytical Labs  
401 North 16th Street  
Sacramento, CA 95814

Calif. Dept. Fish & Game  
Fish and Wildlife WPC Lab  
2005 Nimbus Road  
Rancho Cordova, CA 95670

California Water Labs  
1430 Carpenter Lane  
Modesto, CA 95351

California Water Service  
Co., Lab  
100 N. First Street  
Jose, CA 95112

EAL Corporation  
2030 Wright Avenue  
Richmond, CA 94804

Environmental Research  
Group Inc.  
1400 52nd Street  
Emeryville, CA 94608

Fireman's Fund Insurance  
Company  
Environmental Laboratory  
3333 California Street  
San Francisco, CA 94119

Foremost Research Center  
6363 Clark Ave.  
Dublin, CA 94566

CH2M Hill  
P.O. Box 2088  
Redding, CA 96001

I-Chem Research Corp.  
23787 F Eichler  
Hayward, CA 94545

Jacobs Laboratory  
373 South Fair Oaks Ave  
Pasadena, CA 91105

Los Angeles City Dept. of  
Water and Power  
Sanitary Engineering Water  
Laboratory  
Box 111  
Los Angeles, CA 90051

Met-Chem Engineering Lab.  
3127 "A" Fite Circle  
Sacramento, CA 95827

Metropolitan Water District  
Water Quality Laboratory  
700 North Moreno Avenue  
LaVerne, CA 91750

J.M. Montgomery  
555 East Walnut Ave.  
Pasadena, CA 91101

Morse Labs  
1525 Fulton Ave  
Sacramento, CA 95825

Multi-Tech Laboratories  
14 W. 3rd Street  
Santa Rosa, CA 95401

Radian Corporation  
3401 LaGrande Avenue  
Sacramento, CA 95823

City of San Buenaventura  
Sanitation Laboratory  
P.O. Box 99  
Ventura, CA 93001

Santa Barbara Wastewater  
Treatment Plant  
402 East Mason  
Santa Barbara, CA 93102

Science Applications, Inc  
Trace Environmental Chemi  
Lab  
464 Prospect Street  
La Jolla, CA 92038

Scientific Cleaner & Labor  
2284 Old Middlefield Way  
Mt. View, CA 94043

Stoner Labs  
397 Mathew St.  
Santa Clara, CA 95050

Tetra Tech, Inc.  
630 No. Rosemead Blvd.  
Pasadena, CA 91107

Truesdail Laboratories, I  
4101 North Figueroa St.  
Los Angeles, CA 90065

Water Testing And Consulting  
Laboratory  
Avalon Avenue  
a Barbara, CA 93110

Rock Laboratories, Inc  
14859 East Clark Ave.  
Industry, CA 91745

West Coast Tech. Serv., Inc  
17605 Fabrica Way, Suite D  
Cerritos, CA 90701

---

TMI only

Arco Ventures, Technical Center  
P.O. Box 2600  
Dublin, CA 94566

Contra Costa Water Dist.  
Hollman Filtration Plant  
P.O. Box H20  
Concord, CA 94524

Ecological Systems Corp.  
3200 Colorado Ave.  
a Monica, CA 90404

Escondido City Water Control  
Lab  
100 Valley Blvd.  
Escondido, CA 92025

Kern County Water Agency  
P.O. Box 58  
Bakersfield, CA 93302

Long Beach City Water Dept.  
1300 E. Wardlow Rd.  
Long Beach, CA 90807

No. Marin Co. Water Dist.  
P.O. Box 146  
Novato, CA 94947

San Diego City Utility Dept.  
Water Quality Div., Water Lab.  
7100 Colorado Avenue  
La Mesa, CA 92041

San Francisco Water Dept.  
El Camino Real  
Marbrae, CA 94030

Santa Clara Valley Water Dist.  
400 More Ave.  
Los Gatos, CA 95030

Sweetwater Authority  
386 Third Avenue  
Chula Vista, CA 92010

---

DCEP only

Carnation Research Labs  
8015 Van Nuys Blvd.  
Van Nuys, CA 91412

Certified Testing Labs  
2905 E. Century Blvd.  
South Gate, CA 90280

Dellavalle Laboratory, Inc  
1910 W. McKinley #110  
Fresno, CA 93728

---

PCB only

Lawrence Livermore National  
Laboratory  
Hazards Control Laboratory  
P.O. Box 5505  
Livermore, CA 94550

U.S. Naval Energy & Environ-  
mental Support Activity  
Environmental Water Quality  
Laboratory  
Port Hueneme, CA 93043

---

Except TMI

IT Corporation  
Environmental Division  
4575 Pacheco Blvd.  
Martinez, CA 94553

Soil Control - Marine Bioassay  
1234 Highway 1  
Watsonville, CA 95076

Twining Labs  
2527 Fresno Street  
Fresno, CA 93721

---

Except DECP

Analytical Research Lab.  
Inc.  
160 Taylor Street  
Monrovia, CA 91016

Fruit Growers Lab. Inc  
P.O. Box 272  
Santa Paula, CA 93060

---

Except DECP and PCB

City of Sacramento  
Div. of Water Laboratory  
1301 Jedsmith Drive  
Sacramento, CA 95819

TEST HOLE DEC. 19, 1950  
GROUND ELEV. - 14.4  
WATER LEVEL ELEV. + 9.4

TEST HOLE DEC. 19, 1950  
GROUND ELEV. + 16.1  
WATER LEVEL ELEV. + 10.5

P  
2300 VOLT PARKWAY CABLE Re-linicate

4 - 15,500 BBL. STORAGE TANKS

M  
TRUCK LOADING RACKS  
6 Truck Capacity

TEST BORING  
See log of boring  
on this sheet

TK NO 136

Mark S.E. Corner of plot  
N 7766.7 E 12284.5  
BY 19.31

2 - 3500 BBL WORKING TANKS

TK NO 135

L  
TRUCK UNLOADING FACILITY  
4 Truck Capacity

TANK CAR UNLOADING FACILITY  
5 Car Capacity

Existing 1200 Bbl. Working Tank

Existing 600 Bbl. Receiving Tank

Existing 1200 Bbl. Receiving Tank

NOTE: THIS D

PROJ. CDS. NO. <b>323-316-1</b>		DATE <b>10/27/82</b>		DEPARTMENT OF THE NAVY NAVAL AIR STATION		NAVAL FACILITIES ENGINEERING COMMAND MOFFETT FIELD, CA.	
CHECKED <b>RES</b>		DATE <b>10/27/82</b>		BULK FUEL STORAGE AND SUPPLY PLOT PLAN			
APPROVED BY <i>Bill E. Taylor</i>							
PUBLIC WORKS OFFICE SATISFACTORY TO		SIZE <b>F</b>	CODE IDENT NO. <b>80091</b>	NAVFAC DRAWING NO. <b>PARTIAL 6008033</b>		CONST CONTR. NO.	
SATISFACTORY TO		SCALE <b>No Scale</b>		SPEC.	SHEET <b>1</b> OF <b>1</b>		





32x 216-4 1/2x 1/2x 1/2x  
 1/2x 1/2x 1/2x  
 1/2x 1/2x 1/2x  
 1/2x 1/2x 1/2x

SCALE	NO. SCALING
F	80091
PROJECT NO.	80091
DESIGN NO.	50211
DATE	
BY	
CHECKED BY	
APPROVED BY	

DEPARTMENT OF THE NAVY  
 NAVAL AIR STATION  
 TRANSPORTATION FUEL STORAGE  
 PLOT PLAN

NAVAL FACILITIES ENGINEERING COMMAND  
 MOFFETT FIELD, CA.

See detail A

PROPOSED MONITORING  
 WELL LOCATION

2" suction lines

See detail B

3 H.P. compressor

SERVICE  
 STATION

See detail C

See detail D


6" Water line

3" Water line


8" Water line

H.B.

F.H.

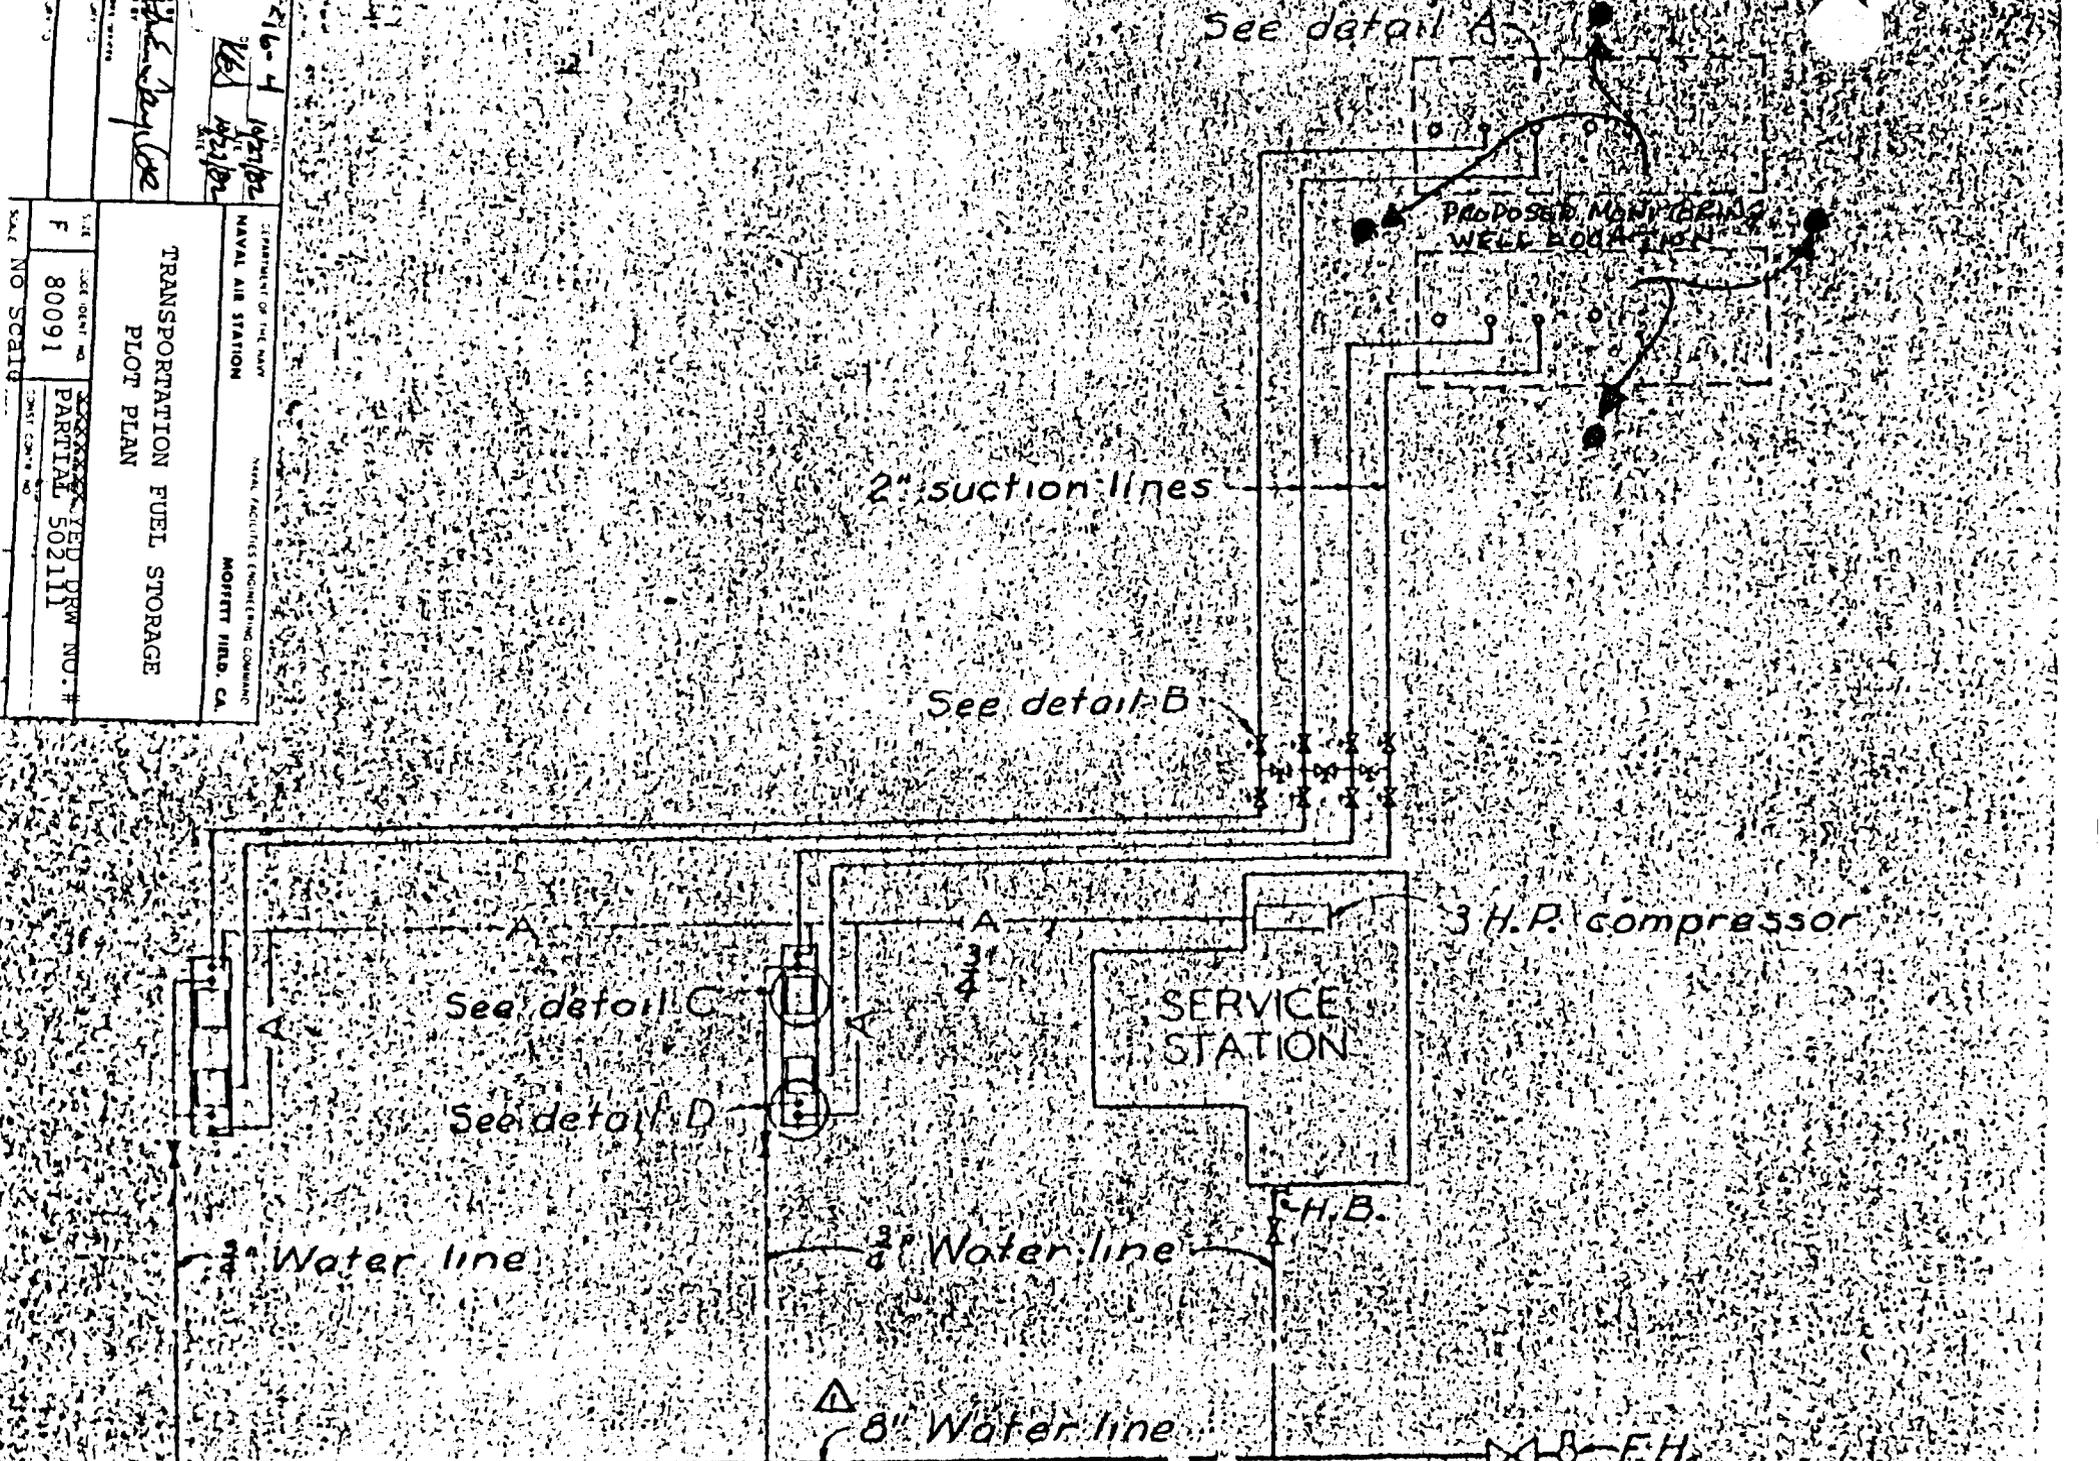


(4) STORAGE TANKS **FUEL FARM BULK STORAGE**  
 13,500 BBL'S EACH  
 800 GPM TRANSFER PUMPS  
 50 GPM SUMP PUMPS

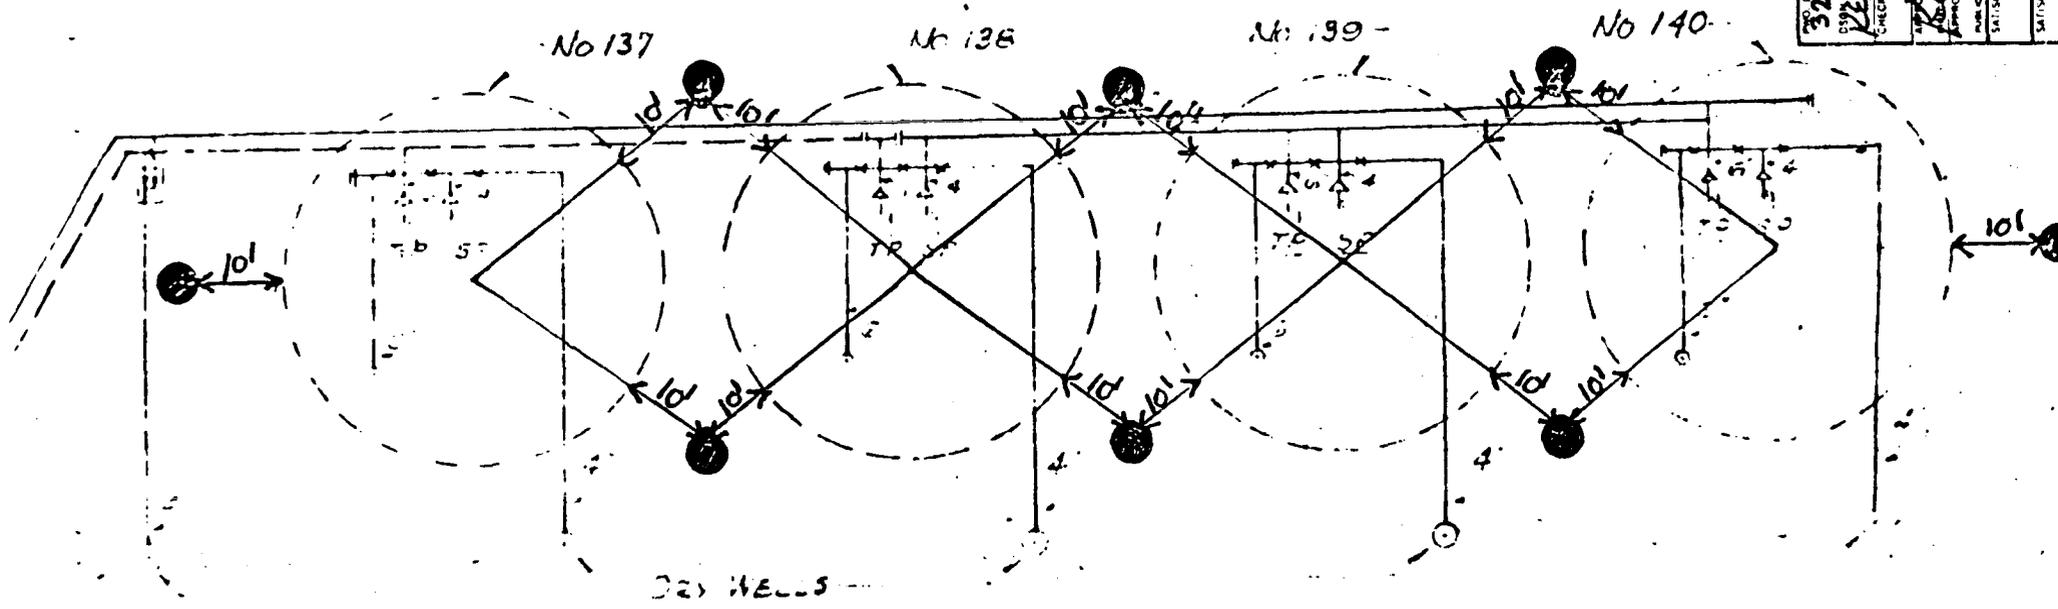

● - PROPOSED MONITORING WELL LOC.

NO. LINES ON THIS SHEET	DATE	DEPARTMENT OF THE NAVY	NAVAL FACILITIES ENGINEERING COMMAND
323-516-5	10/27/68	NAVAL AIR STATION	MOFFETT FIELD
DESIGNED BY	CHECKED	FUEL FARM BULK STORAGE TANKS PLOT PLAN	
RED	RED		
DRAWN BY		PROJECT NO.	
E. J. Jay		5600000000 YED DRW N	
APPROVED BY		PARTIAL 501494	
PUBLIC WORKS OFFICE		SIZE	CODE IDENT. NO.
SATISFACTORY TO		F	80091
SATISFACTORY TO		CONST. CONTR. NO.	
		NO. 501494	

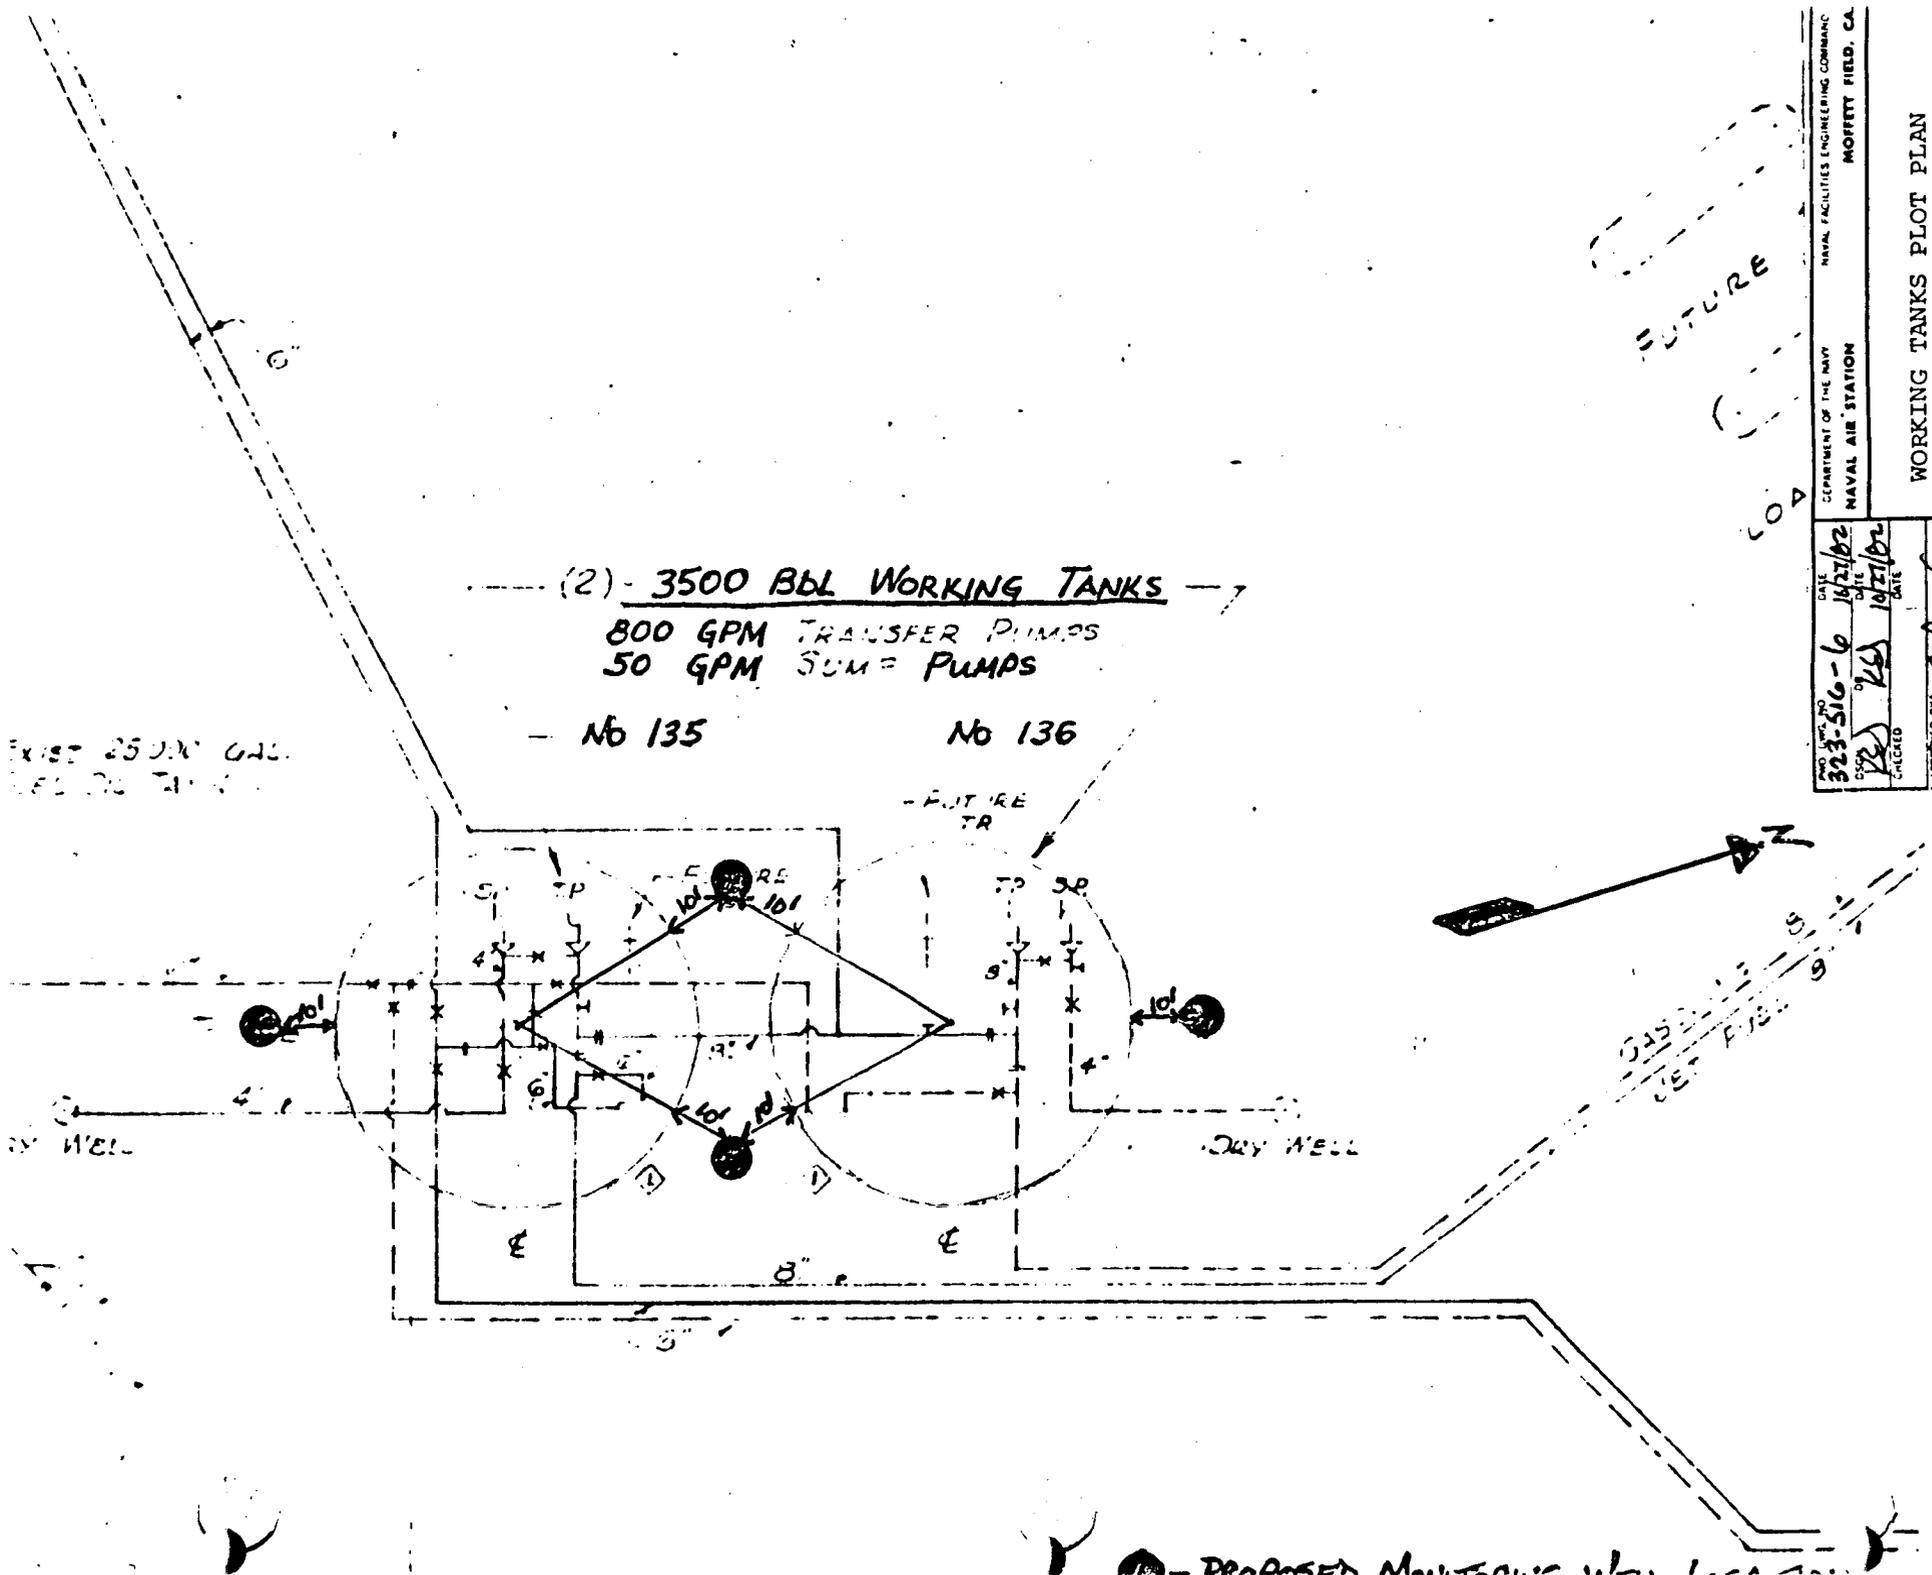

(2) - 3500 BBL WORKING TANKS  
 800 GPM TRANSFER PUMPS  
 50 GPM SUM PUMPS  
 - No 135                      No 136

EXIST 2500 GAL  
 1500 GAL TANK


FUTURE  
 COA

DATE 10/1/62		NAVAL FACILITIES ENGINEERING COMMAND	
NO. 323-516-6		MOFFETT FIELD, CA	
DESIGNED BY KES	DATE 10/1/62	DEPARTMENT OF THE NAVY	
CHECKED BY		NAVAL AIR STATION	
APPROVED BY [Signature]		WORKING TANKS PLOT PLAN	
SALES OFFICE		SIZE F	CODE DEPT. NO. 80091
SALES OFFICE TO		UNCLASSIFIED DRAW NO. PARTIAL 501494	
SALES OFFICE TO		CONST. CONTR. NO.	

PROPOSED MANIFOLD

Ex. ST. 200 35.  
RECEIVING TANK NO 59  
 800 GPM TRANSFER PUMP  
 25 GPM SUMP PUMP (EXIST.)

Ex. ST. 200 56.  
WORKING TANK 1  
 800 GPM TRANSFER  
 25 GPM SUMP PUMP

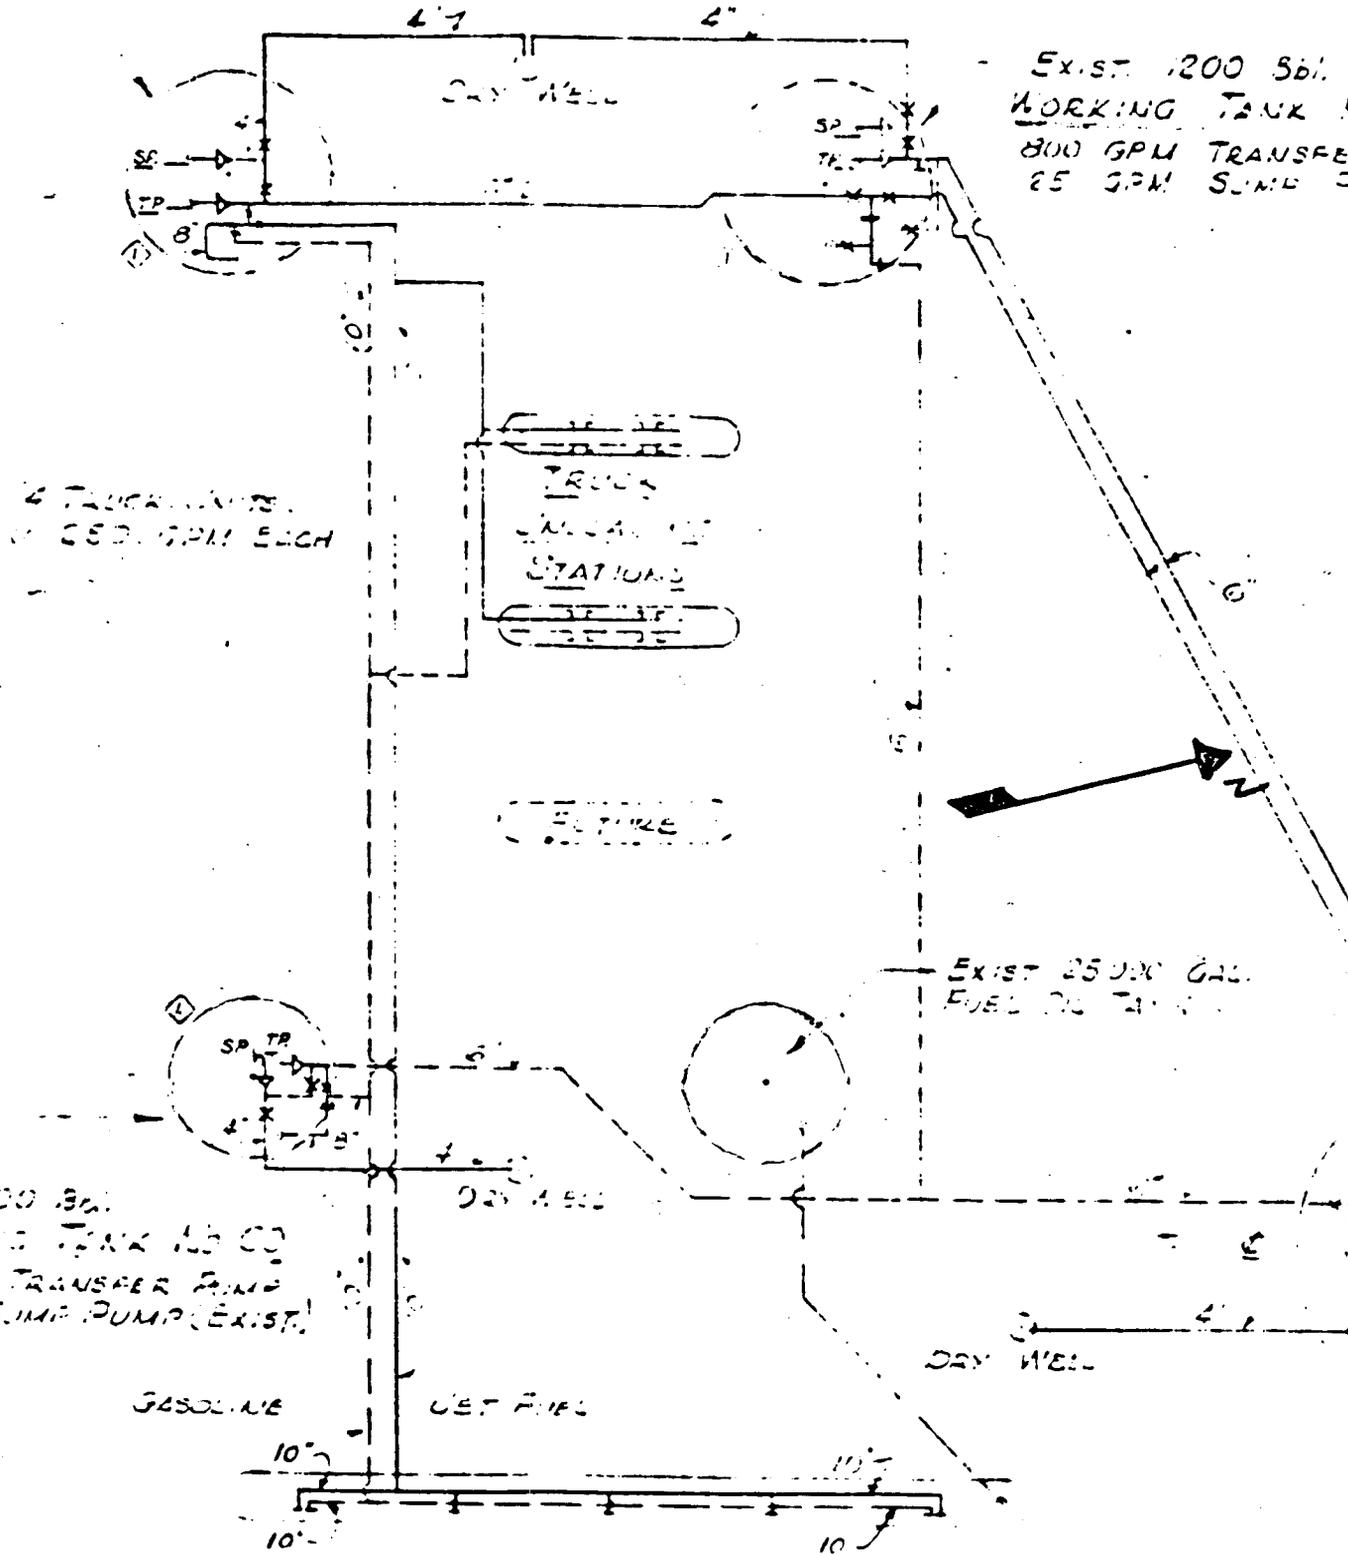


Ex. ST. 600 36.  
RECEIVING TANK NO 60  
 800 GPM TRANSFER PUMP  
 25 GPM SUMP PUMP (EXIST.)

EXIST. 25,000 GAL. FUEL OIL TANK

TANK CAR  
 5 CAR C  
 6 200 G

PROJ. ORG. NO. <b>323-516-7</b>	DATE <b>10/27/02</b>
DESIGNED BY <b>RED</b>	DATE <b>10/27/02</b>
CHECKED BY <b>KGD</b>	DATE
APPROVED BY <i>[Signature]</i>	
PUBLIC WORKS OFFICER	
SATISFACTORY TO	
SATISFACTORY TO	

DEPARTMENT OF THE NAVY NAVAL AIR STATION		NAVAL FACILITIES ENGINEERING COMMAND MOFFETT FIELD.	
FUEL TRUCK LOADING FACILITY TANK PLOT PLAN			
SIZE <b>F</b>	CODE IDENT NO. <b>80091</b>	REVISED DRAWING NO. <b>PARTIAL 6099484</b>	
SCALE <b>No Scale</b>		SPEC	SHEET 1 OF

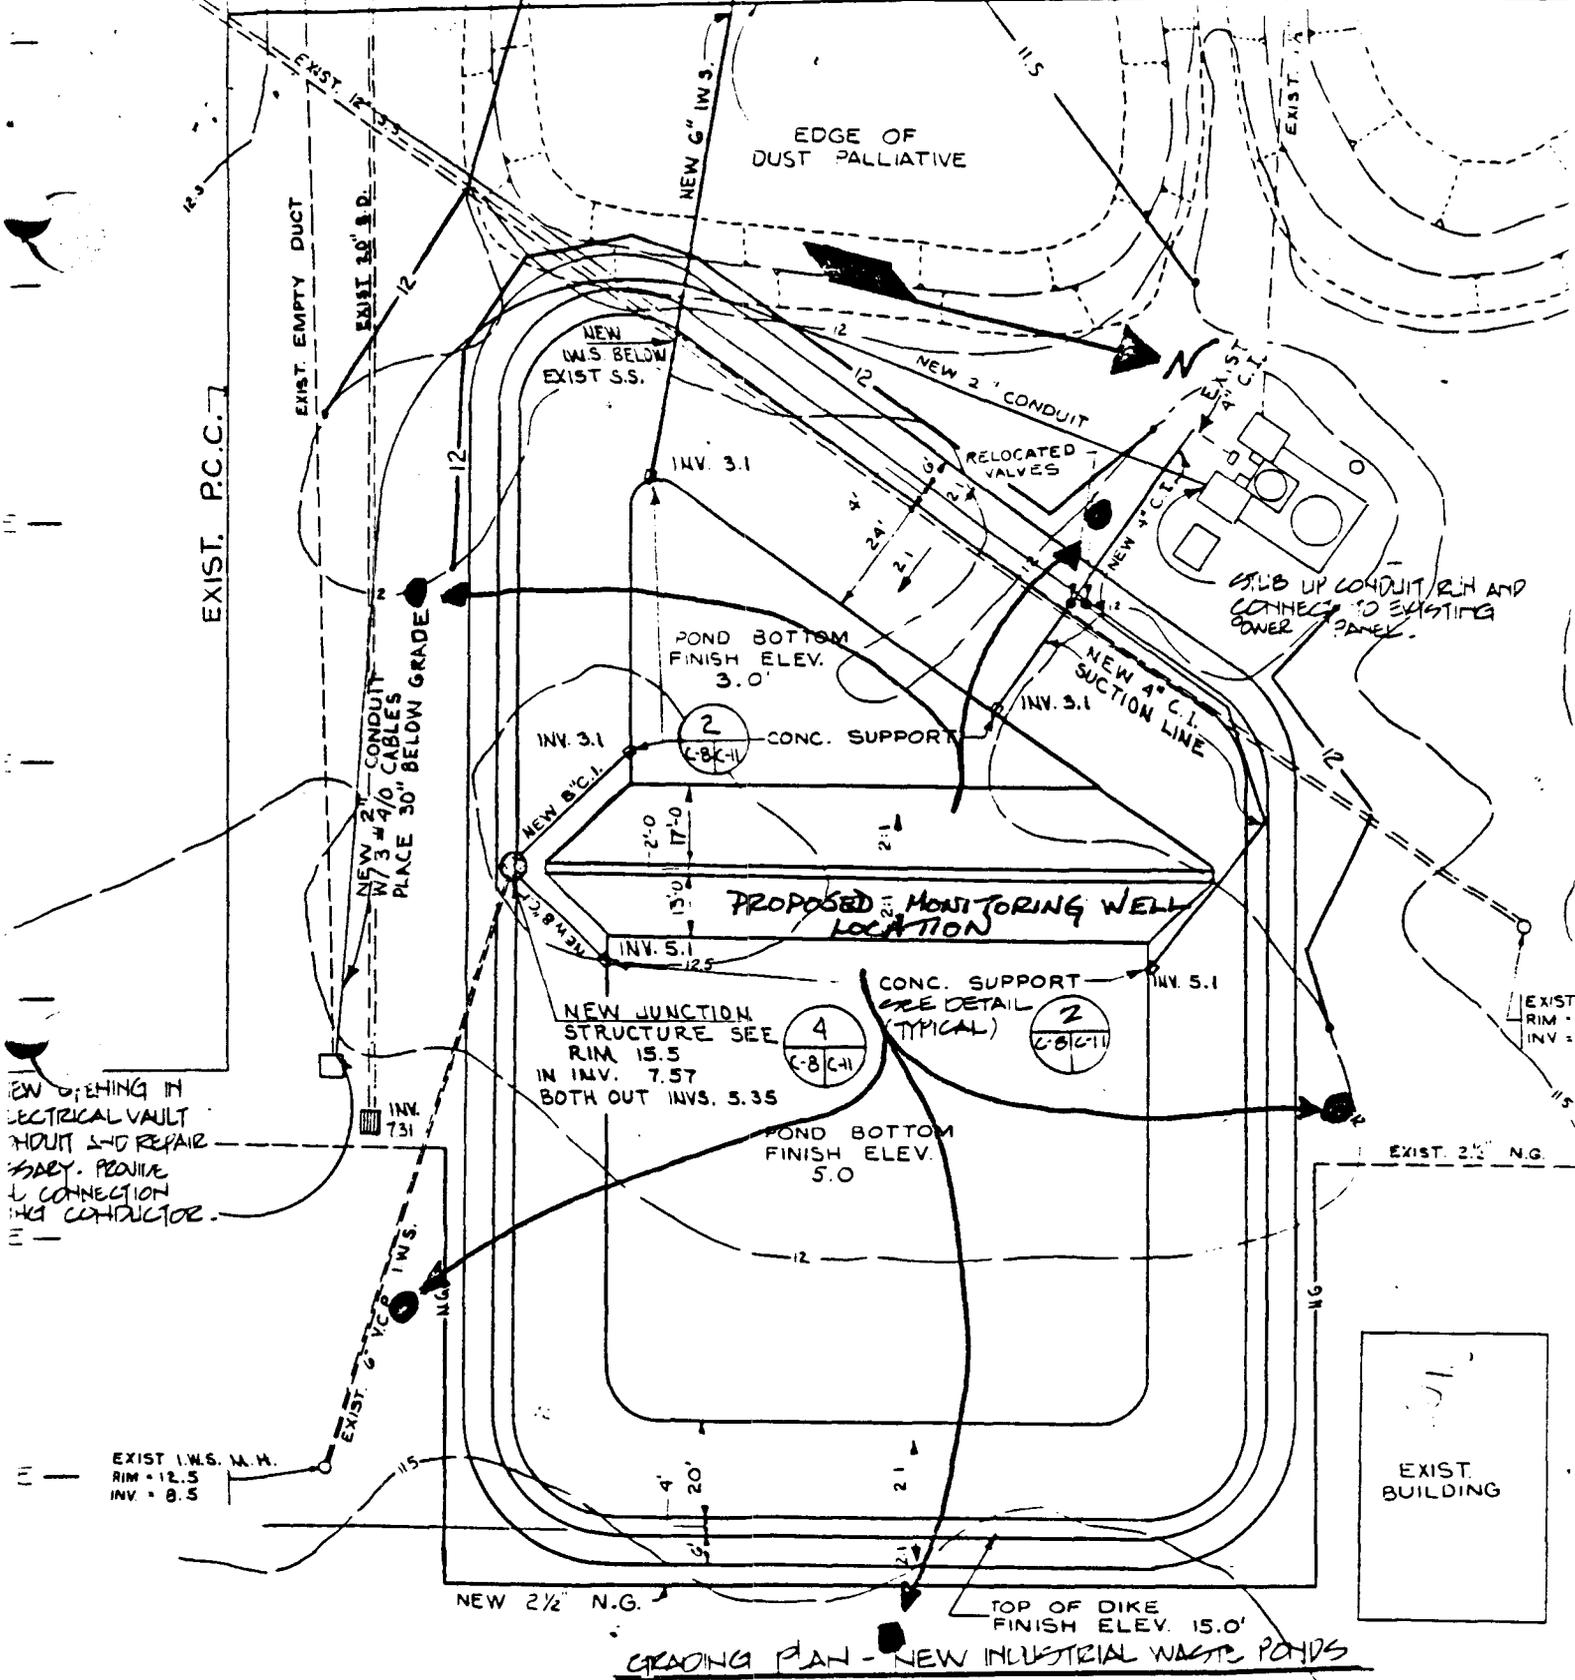


NEW WORKING IN ELECTRICAL VAULT ROUTE AND REPAIR W/ 3 #4/0 CABLES. PROVIDE CONNECTION TO CONDUCTOR.

CLUB UP CONDUIT/RUN AND CONNECT TO EXISTING POWER PANEL.

**GRADING PLAN - NEW INDUSTRIAL WASTE PONDS**

SCALE: 1" = 20'

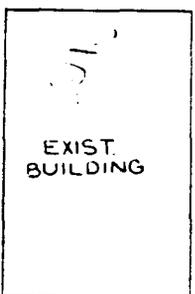

IF SHEET IS A RE SCALE REDUC



NOTE: SEE SHEET T-2

PROJ. NO. <b>323-516-B</b> DATE <b>10/21/02</b> DESIGNED BY <b>RES</b> CHECKED BY <b>RES</b> DATE <b>10/21/02</b>	DEPARTMENT OF THE NAVY NAVAL AIR STATION NAVAL FACILITIES ENGINEERING COM MOFFETT FIELD
APPROVED BY <i>[Signature]</i> APPROVED BY PUBLIC WORKS OFFICE SATISFACTORY TO	<b>INDUSTRIAL WASTE PONDS (FLUC PONDS) PLOT PLAN</b> SIZE: <b>F</b> CODE IDENT NO.: <b>80091</b> NAVFAC DRAWING NO.: <b>PARTIAL 6099484</b> CONST CONTR NO.
SCALE: <b>No Scale</b>	SHEET 1 OF 1